


PLAT AND RECORD

Of a Survey on Section 29 T. 2 R. 14 E. of the 4th BRADFORD Township  
Rock County, Wisconsin, made MAY 20 1980

I hereby certify that the following is a correct record of said survey as made by me.

COUNTY BUILDING  
CITY OF JANESVILLE

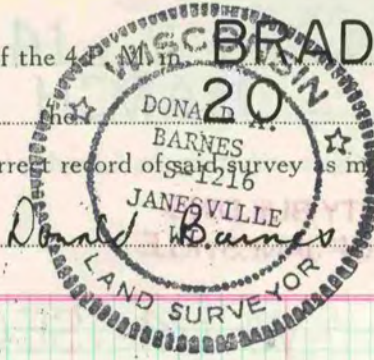

County Surveyor.

W 1/4 COR SEC 29

SET ALUM MON FROM TIES FROM VOL 5 PG 492

MICROFILMED

NW COR SEC 27

SET ALUM MON ON TOP OF RECORD HH.

