

**MICROFILMED**

# PLAT AND RECORD


Of a Survey on Section 5 T 2 R 9 E. of the 4 P. M. in \_\_\_\_\_ Township

Rock County, Wisconsin, made May the 7th 1890

COUNTY BUILDING  
CITY OF JANESVILLE

I hereby certify that the following is a correct record of said survey as made by me.

(Signed) O. G. Bleedorn Dep.  
P. H. B. County Surveyor.

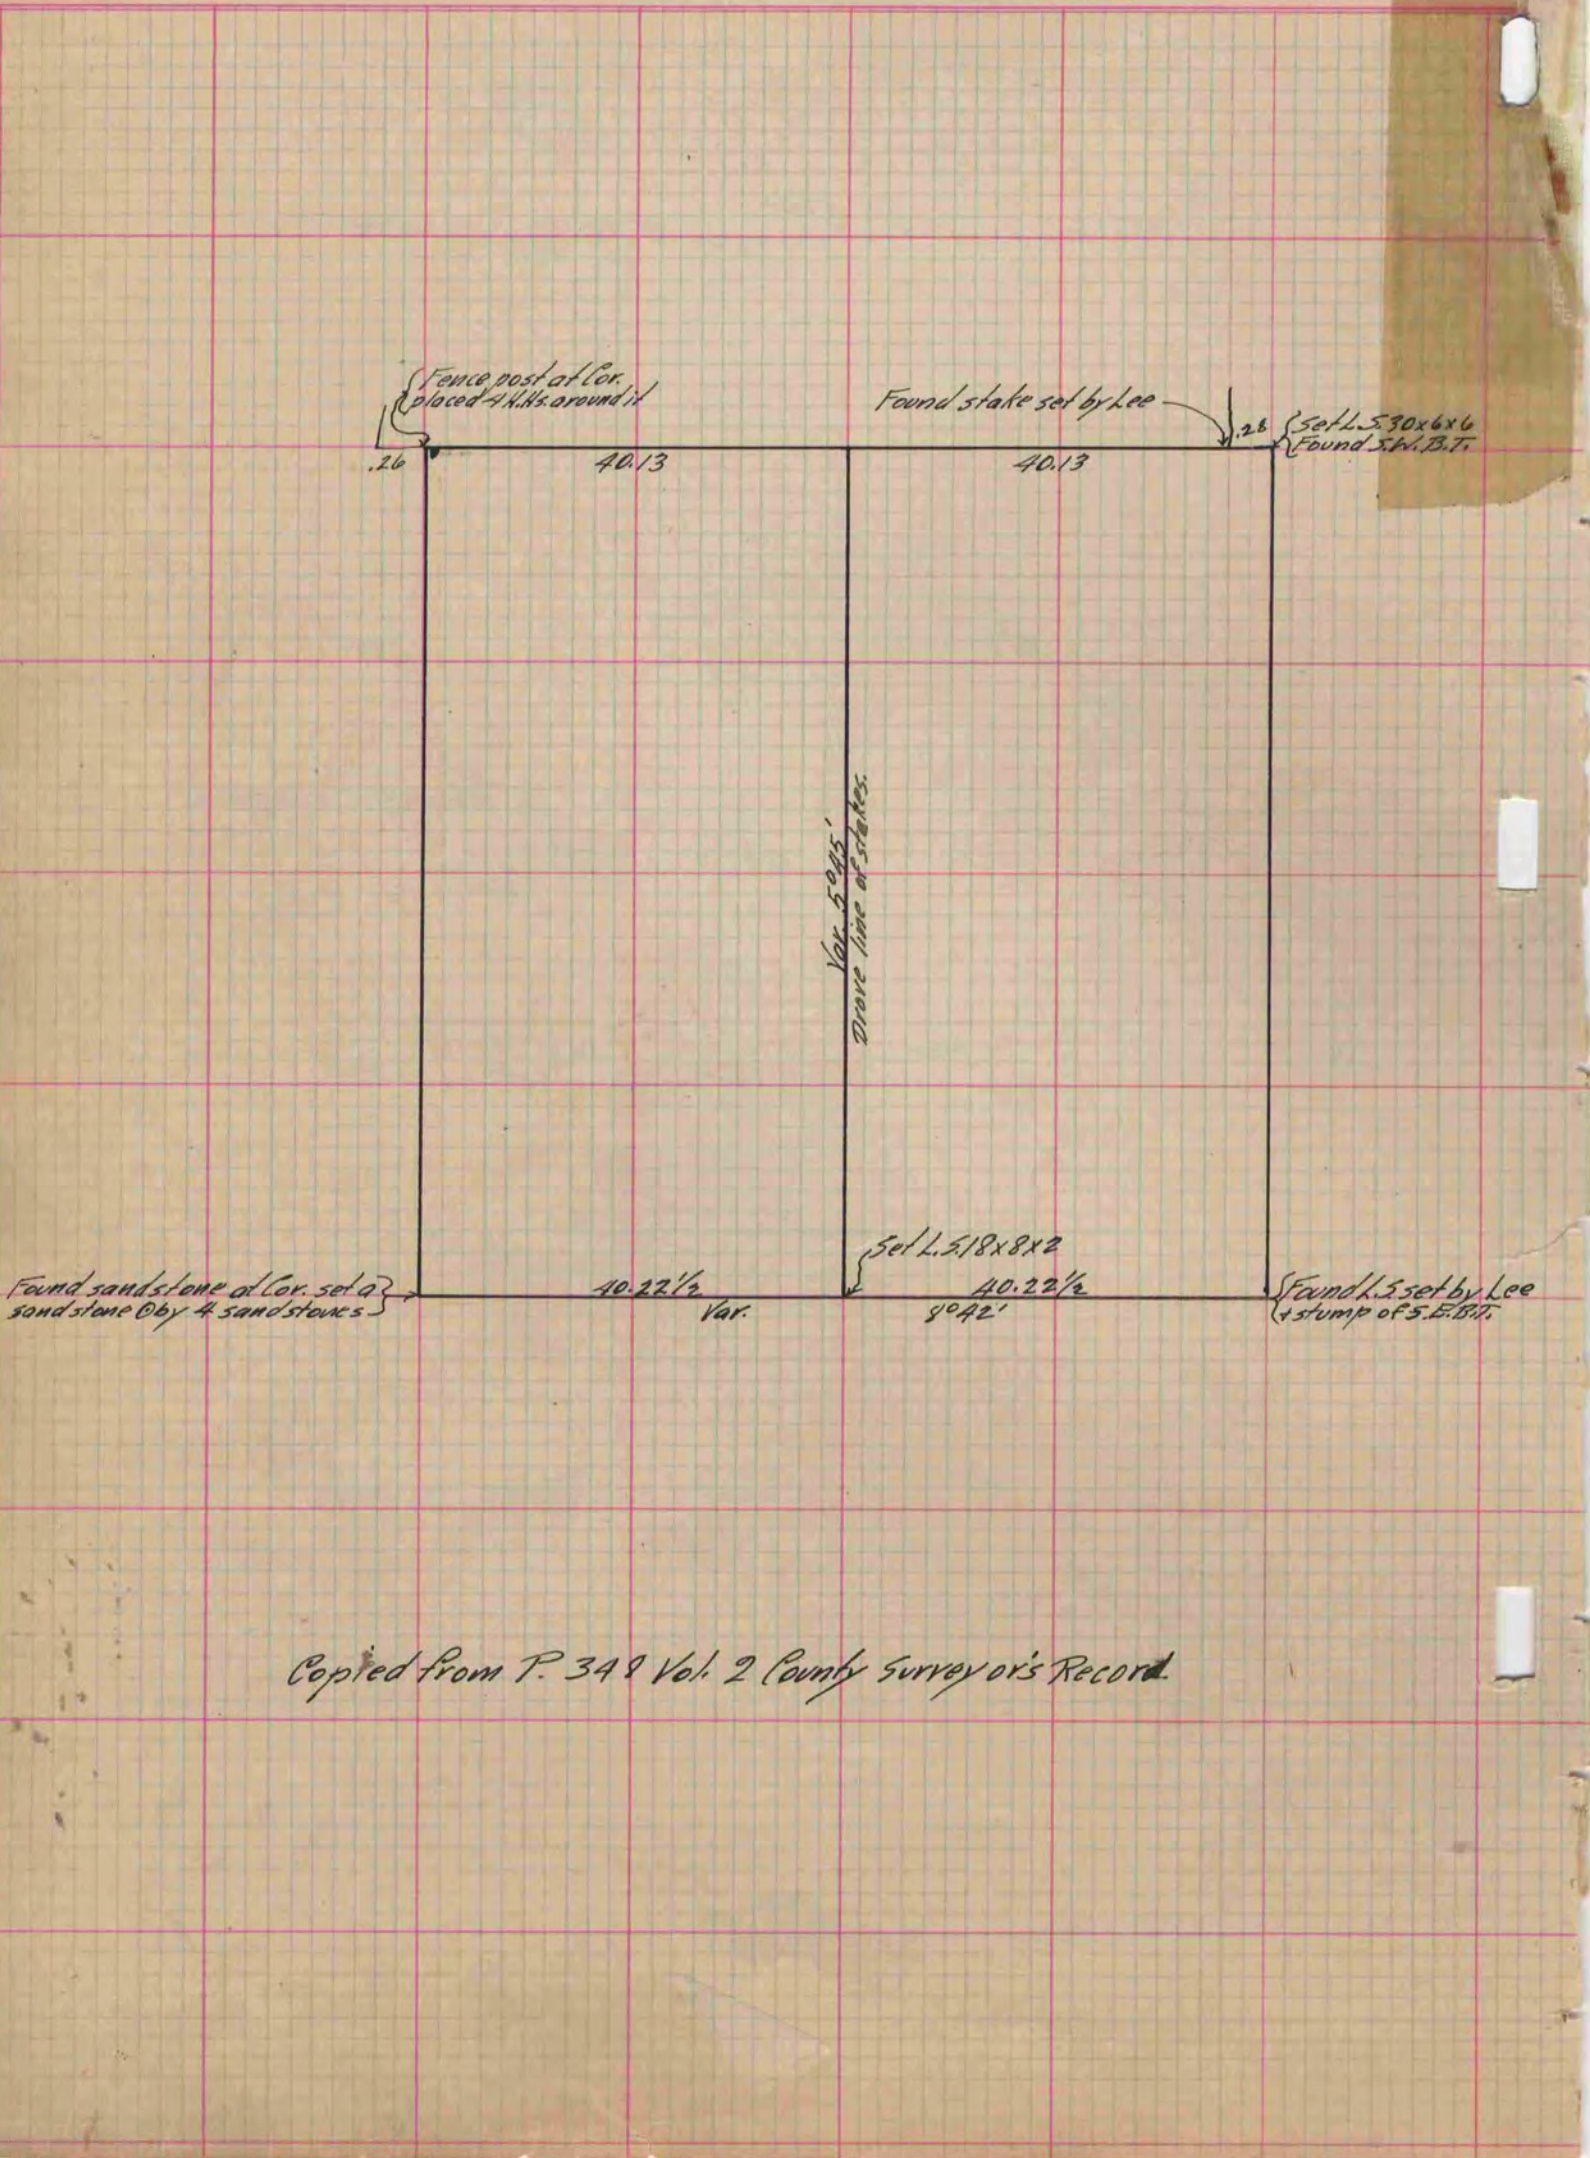

Copied from P. 349 Vol. 2 County Surveyor's Record.