

MICROFILMED PLAT AND RECORD

Of a Survey on Section 6 T 1 R 9 E. of the 4 P. M. in Green Township


~~Rock~~ County, Wisconsin, made March the 18+19 1870

I hereby certify that the following is a correct record of said survey as made by me.

COUNTY BUILDING
CITY OF JANESVILLE

(Signed) Edward J. Rucker

County Surveyor.

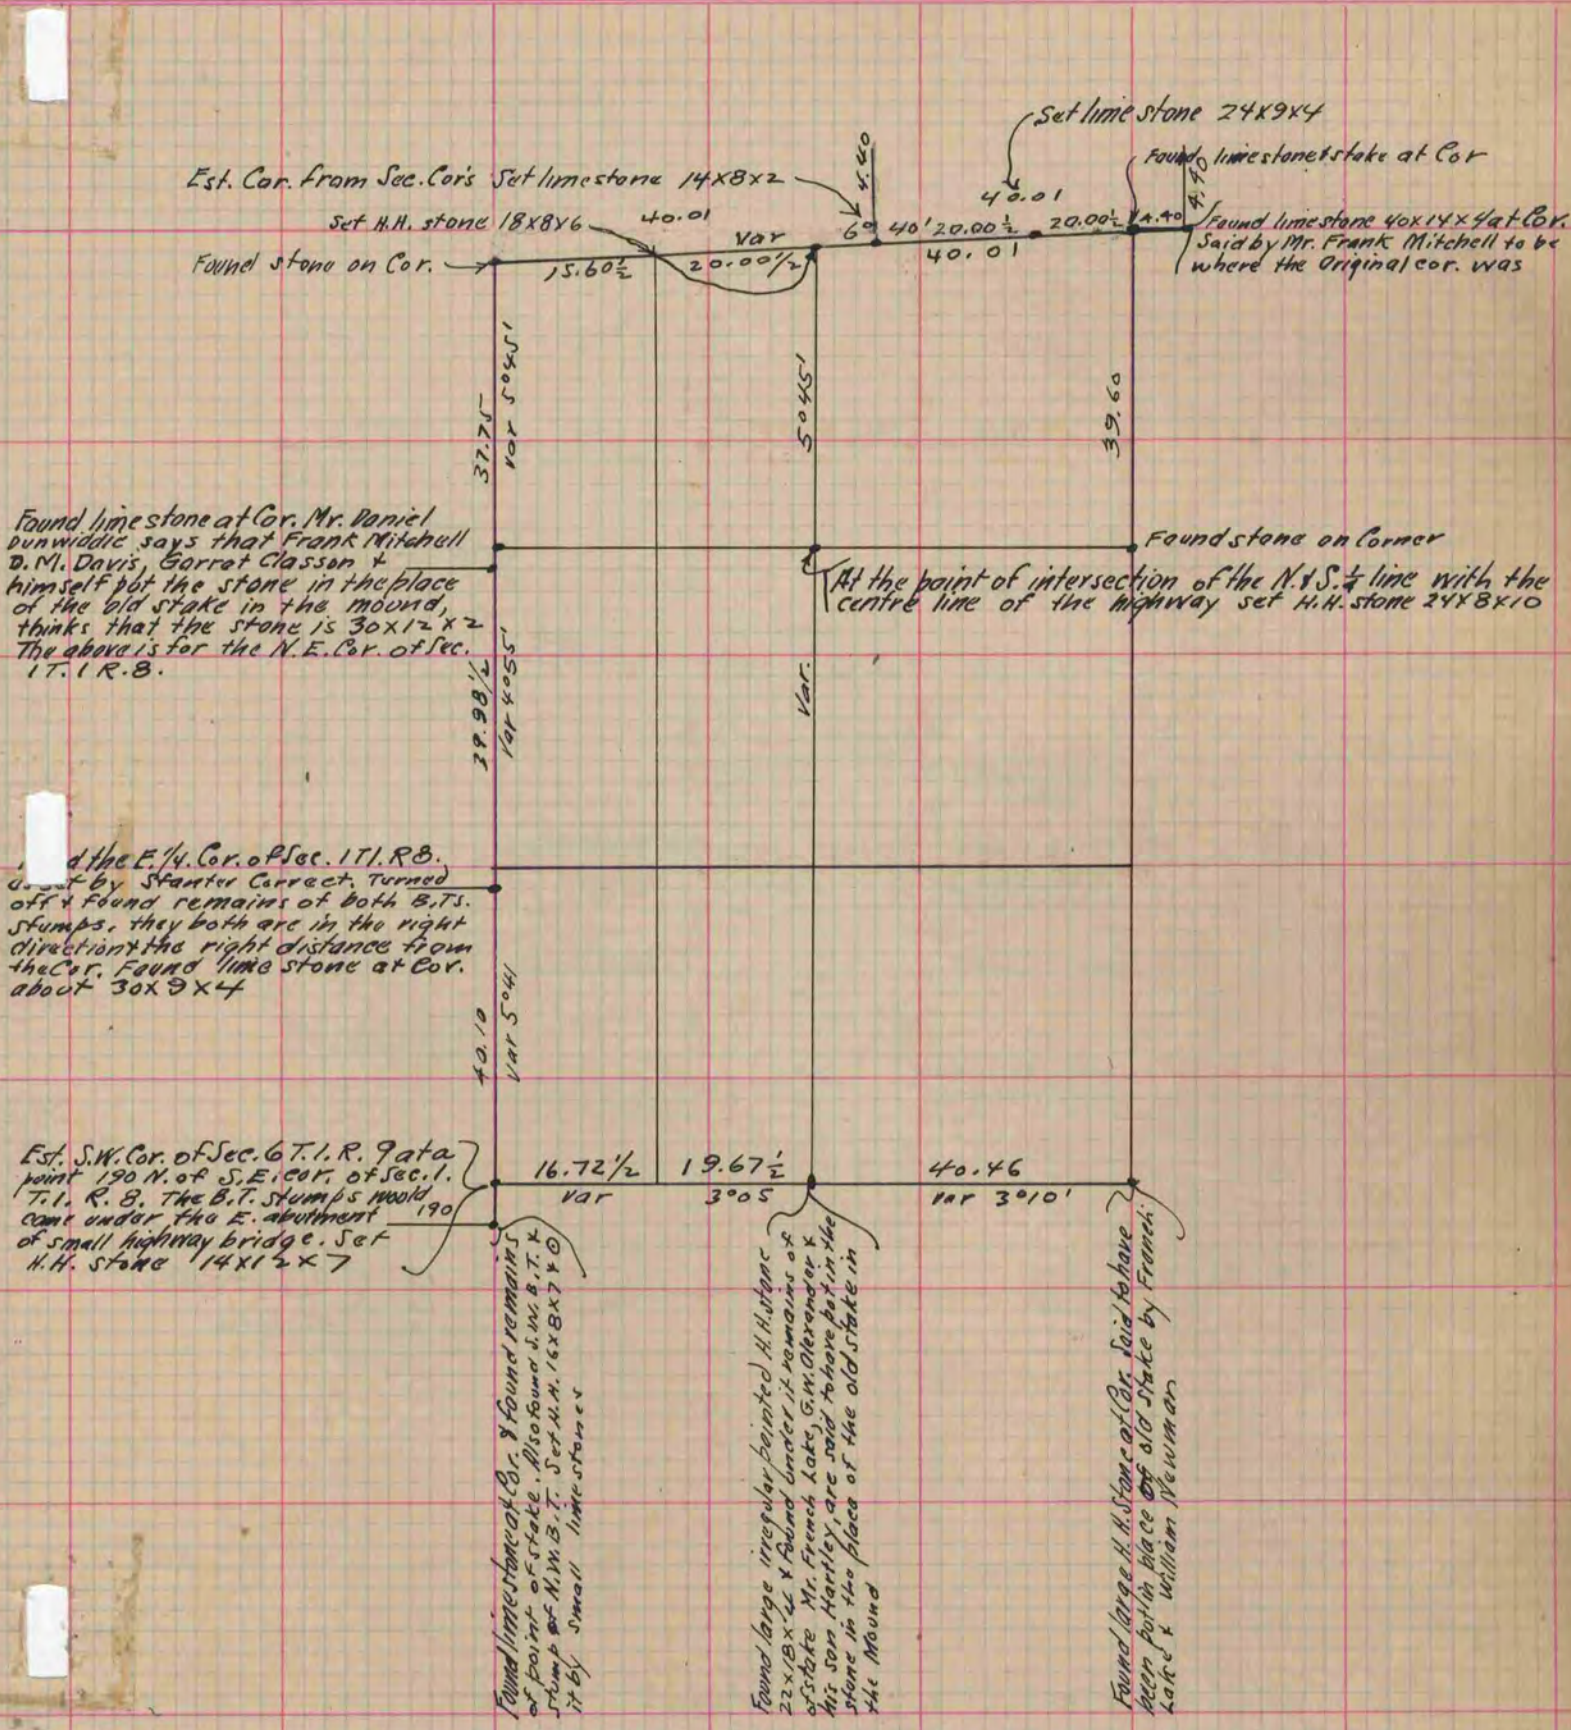

Copied from page 197 Vol. 2. County Surveyors Record.