

# PLAT AND RECORD


**MICROFILMED**

Of a Survey on Section 9 T3N. R12 E. of the 4 P. M. in JANESVILLE Township

Rock County, Wisconsin, made June the \_\_\_\_\_ 1934

I hereby certify that the following is a correct record of said survey as made by me.

COUNTY BUILDING  
CITY OF JANESVILLE

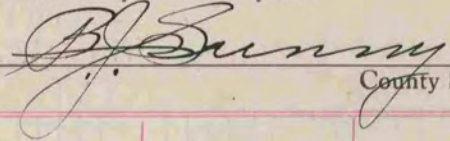

County Surveyor.

*see recorded plat of  
RIVER HILLS SUBDIVISION  
Vol. 9, page 67*