

MICROFILMED

PLAT AND RECORD

COUNTY BUILDING
CITY OF JANESVILLE


Of a Survey on Section 13 T 1 R 10 E. of the 4 P. M. in Avon Township

Rock County, Wisconsin, made October the 23 1871

I hereby certify that the following is a correct record of said survey as made by me.

(Signed) Edward Ruger
R.H.B. County Surveyor.

See Section 24 Avon Page 31 (18 this Book).

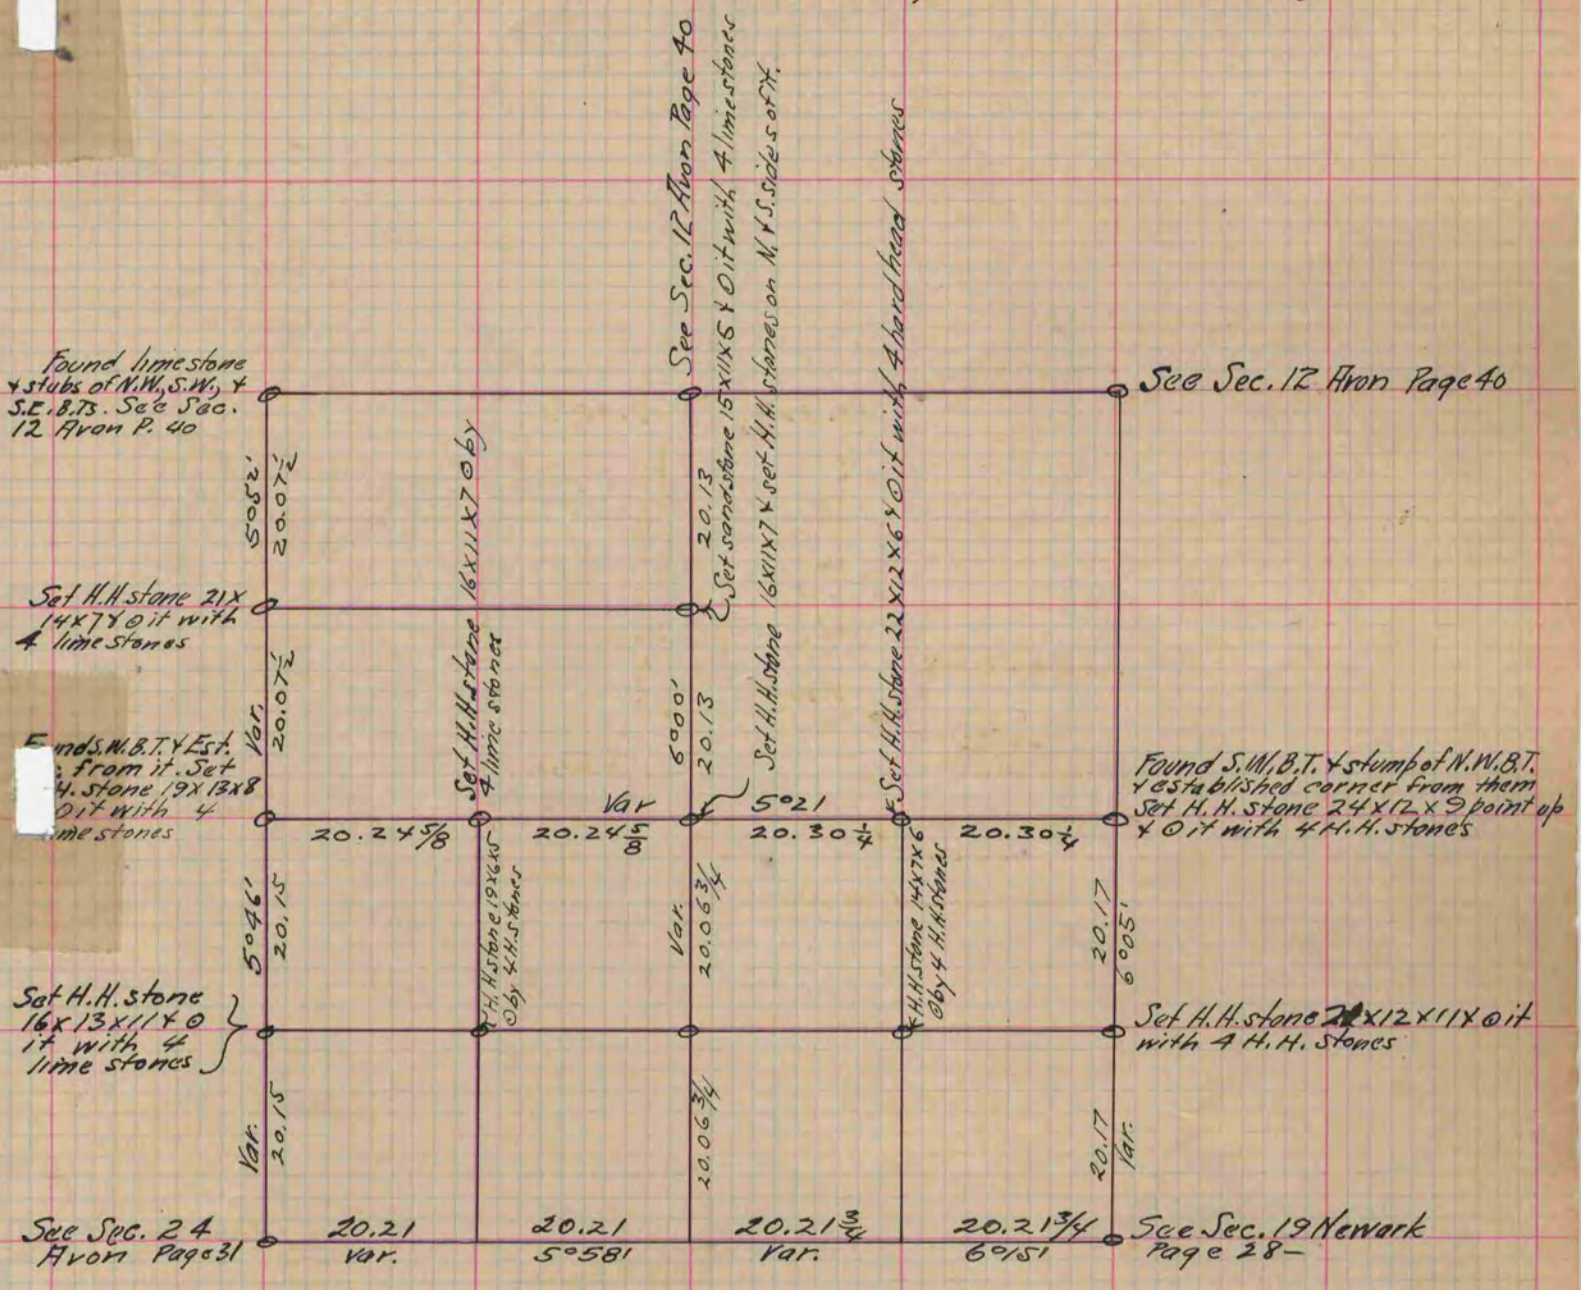

Copied from P. 44 Vol. 2 Original County Surveyors Record