

**MICROFILMED**

# PLAT AND RECORD

371  
V-2

COUNTY BUILDING  
CITY OF JANESVILLE

Of a Survey on Section 18 T 4 R 12 E. of the 4 P. M. in Fulton Township


Rock County, Wisconsin, made May the 18<sup>th</sup> + 19<sup>th</sup> 1882

I hereby certify that the following is a correct record of said survey as made by me.

(Signed) R. K. Lee  
R. H. B.

Dep. County Surveyor.

To determine area of Pease Estate  
A plat was furnished the Administrator D. F. Sayre

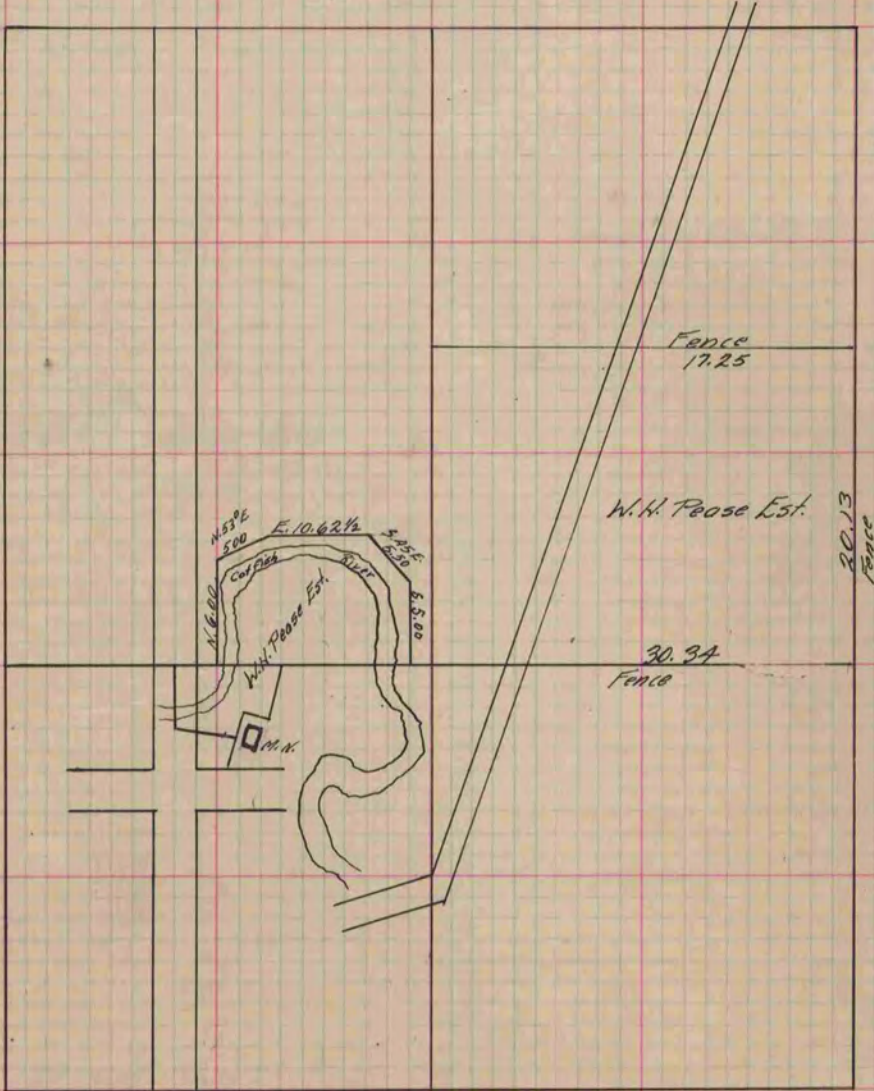

Copied from P. 299 Vol. 2 County Surveyors Record.