

V-1  
**MICROFILMED**

# PLAT AND RECORD


Of a Survey on Section 4 T 2 R 11 E. of the 4 P. M. in Plymouth Township  
Rock County, Wisconsin, made March the 31<sup>st</sup> 1865

**COUNTY BUILDING  
CITY OF JANESVILLE**

I hereby certify that the following is a correct record of said survey as made by me.

(Signed) S. D. Locke  
R.H.B. County Surveyor.

Found old stake set poplar stake with lime stone  
20x12x8 on N + lime 20x6x4 on S. and  
smaller one on W. in ground

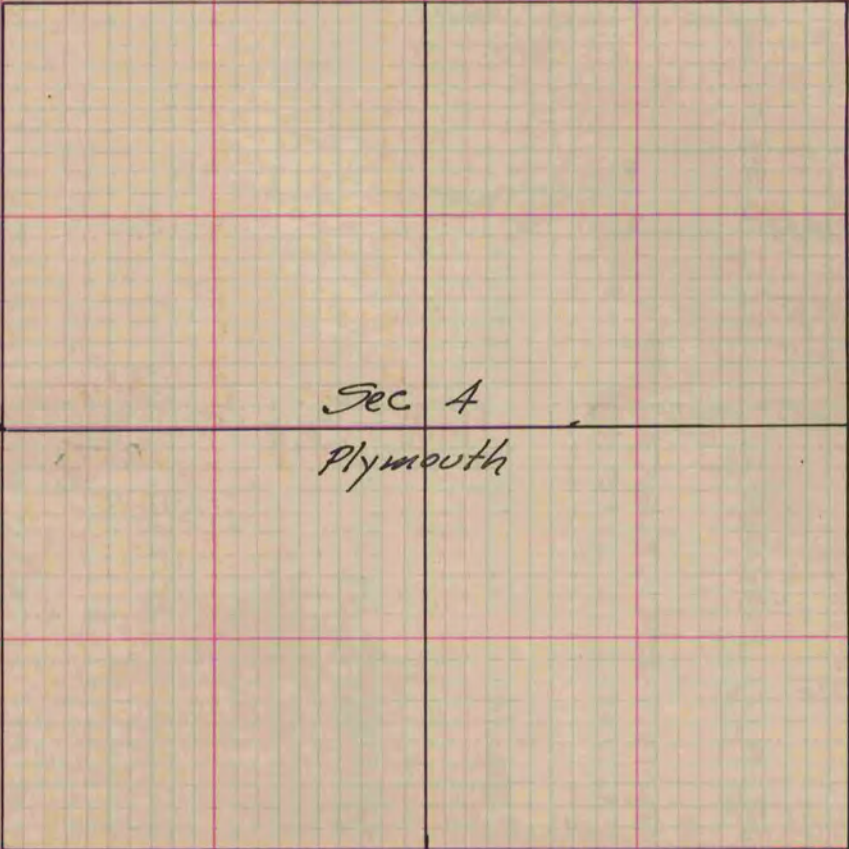

*Copied from Page 216 Vol. 1. Original County Surveyors Record*