

MICROFILMED

PLAT AND RECORD


COUNTY BUILDING
CITY OF JANESVILLE

Of a Survey on Section 36 T 4 R 12 E. of the 4 P. M. in Fulton Township

Rock County, Wisconsin, made October the 24 1867

I hereby certify that the following is a correct record of said survey as made by me.

(Signed) S. D. Locke
R. H. B. County Surveyor.

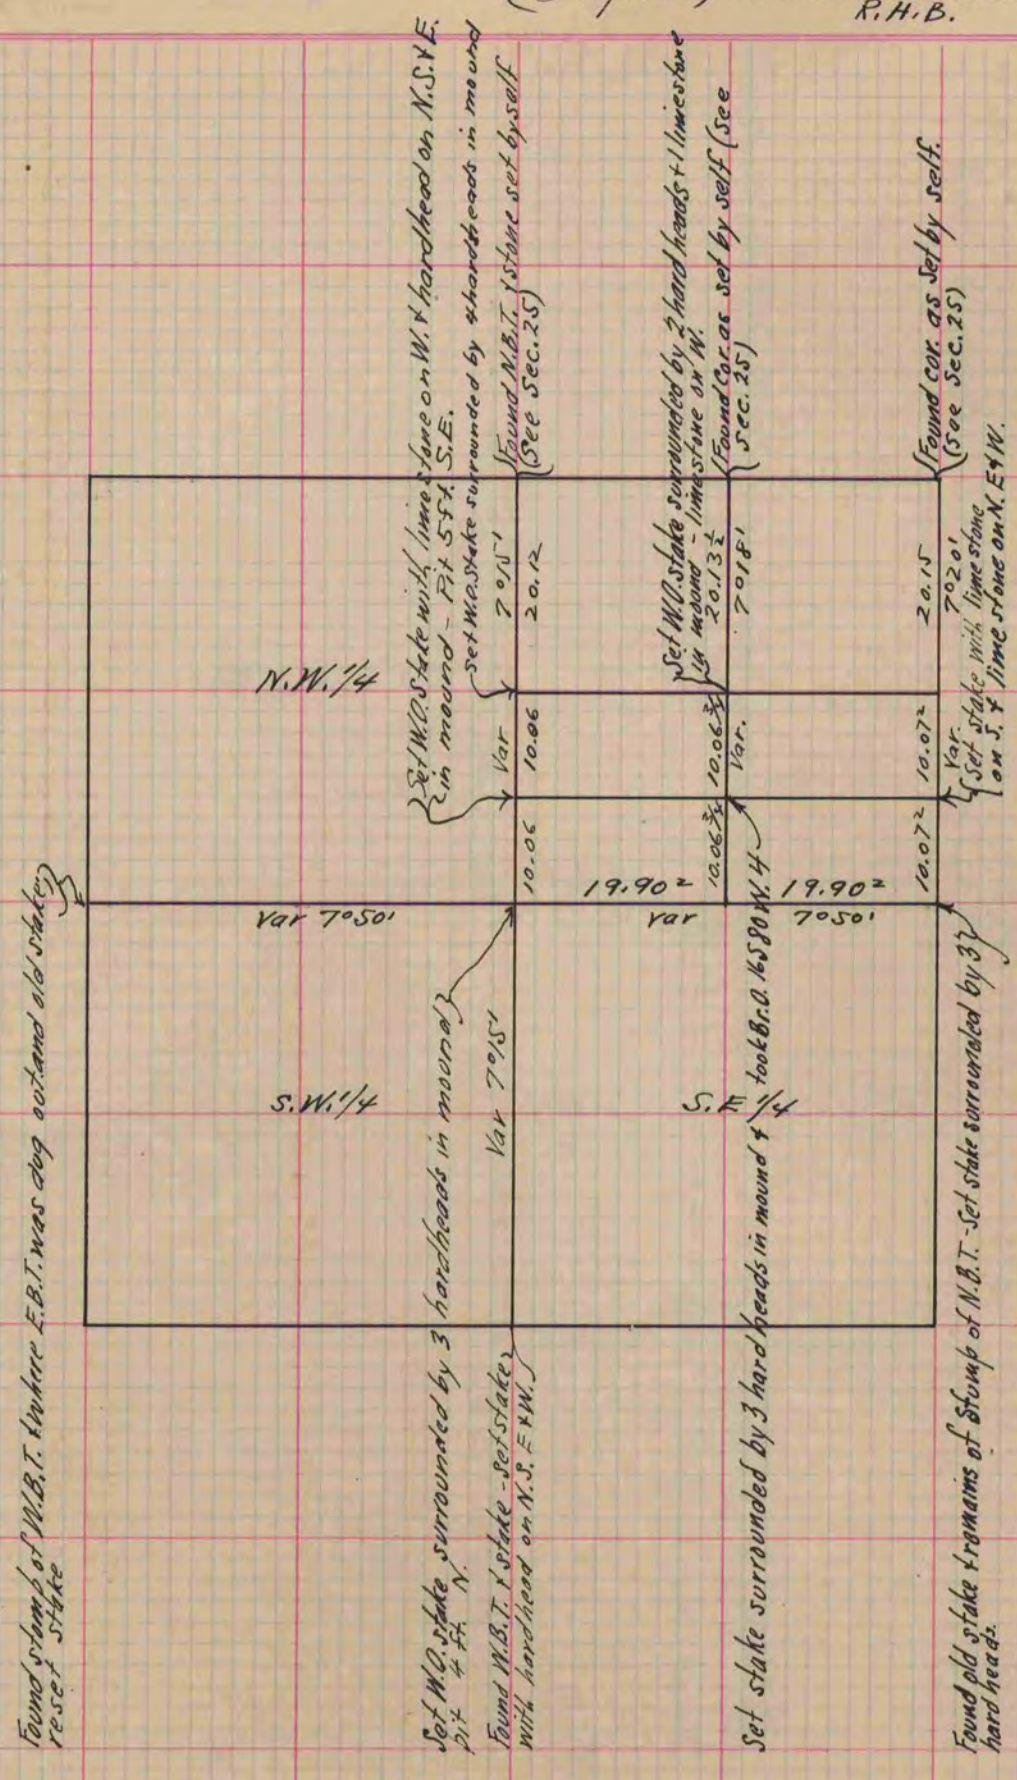

Copied from Page 253 Vol. 1. Original County Surveyors Record