

MICROFILMED

PLAT AND RECORD

1
V-2

COUNTY BUILDING
CITY OF JANESVILLE


Of a Survey on Section 11 T 2 R 11 E. of the 4 P. M. in Plymouth Township

Rock County, Wisconsin, made October the 27th & 28th & 29th 1869

I hereby certify that the following is a correct record of said survey as made by me.

(Signed) R. K. Lee
R.H.B. Dep. County Surveyor.

JANESVILLE SET [LOOSE-LEAF BOUND]

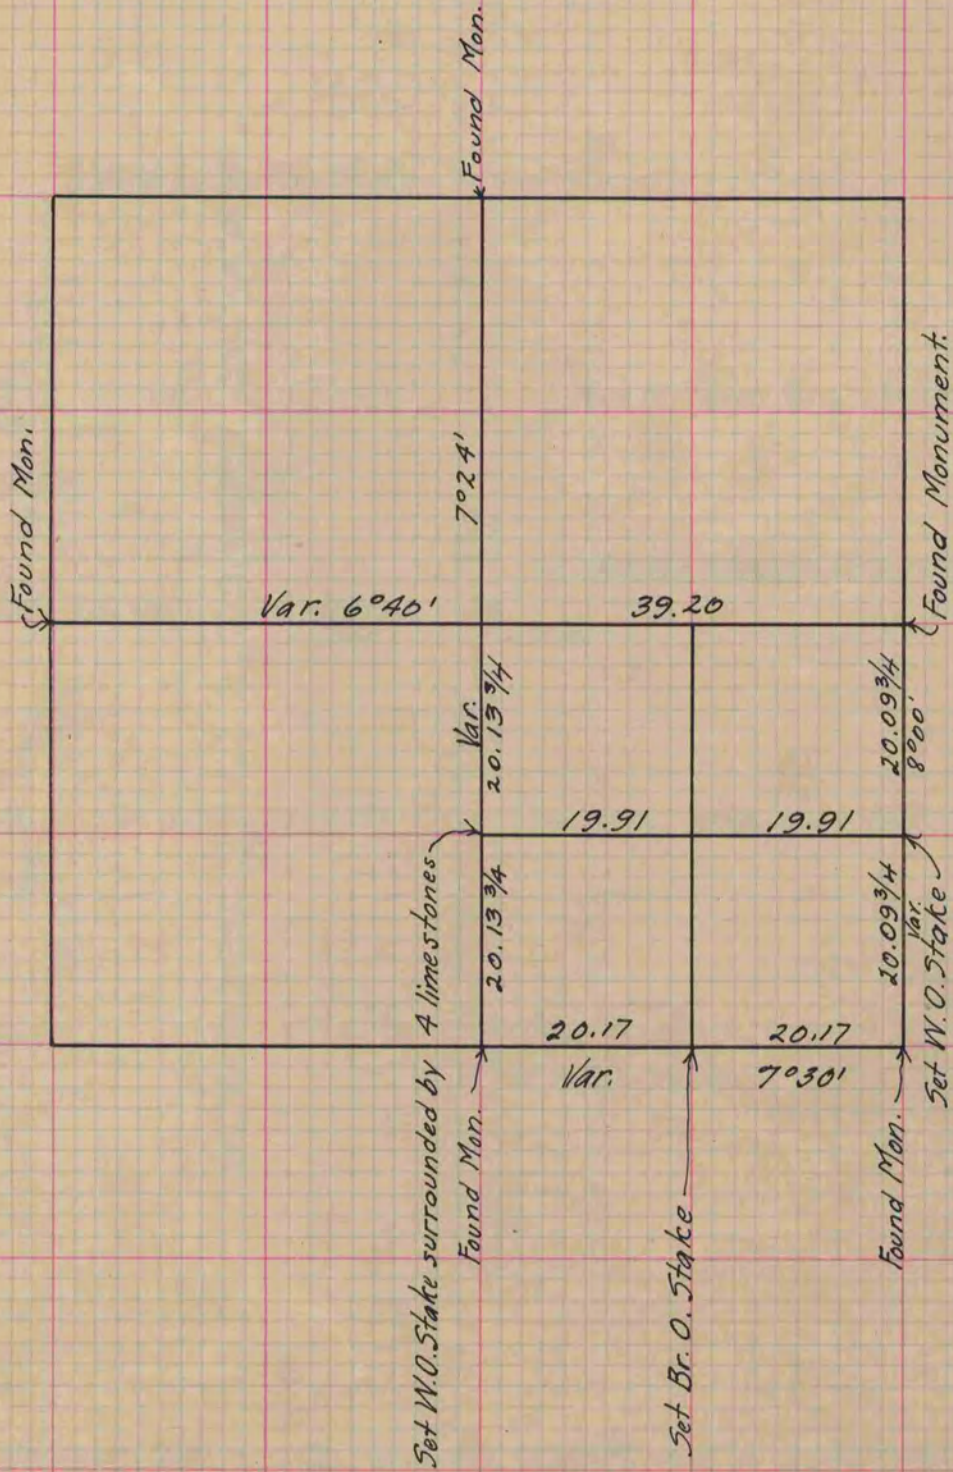

Copied from Page 7 Vol. 2 Original County Surveyors Record

Note: Pages preceding Page 7 Vol. 2 are used for indexing.