


MICROFILMED PLAT AND RECORD

COUNTY BUILDING
CITY OF JANESVILLE

Of a Survey on Section 2 T 4 R 13 E. of the 4 P. M. in Harmony Township
Rock County, Wisconsin, made December the 18th 1869

I hereby certify that the following is a correct record of said survey as made by me.

(Signed) R. K. Lee Deputy
R.H.B. County Surveyor.

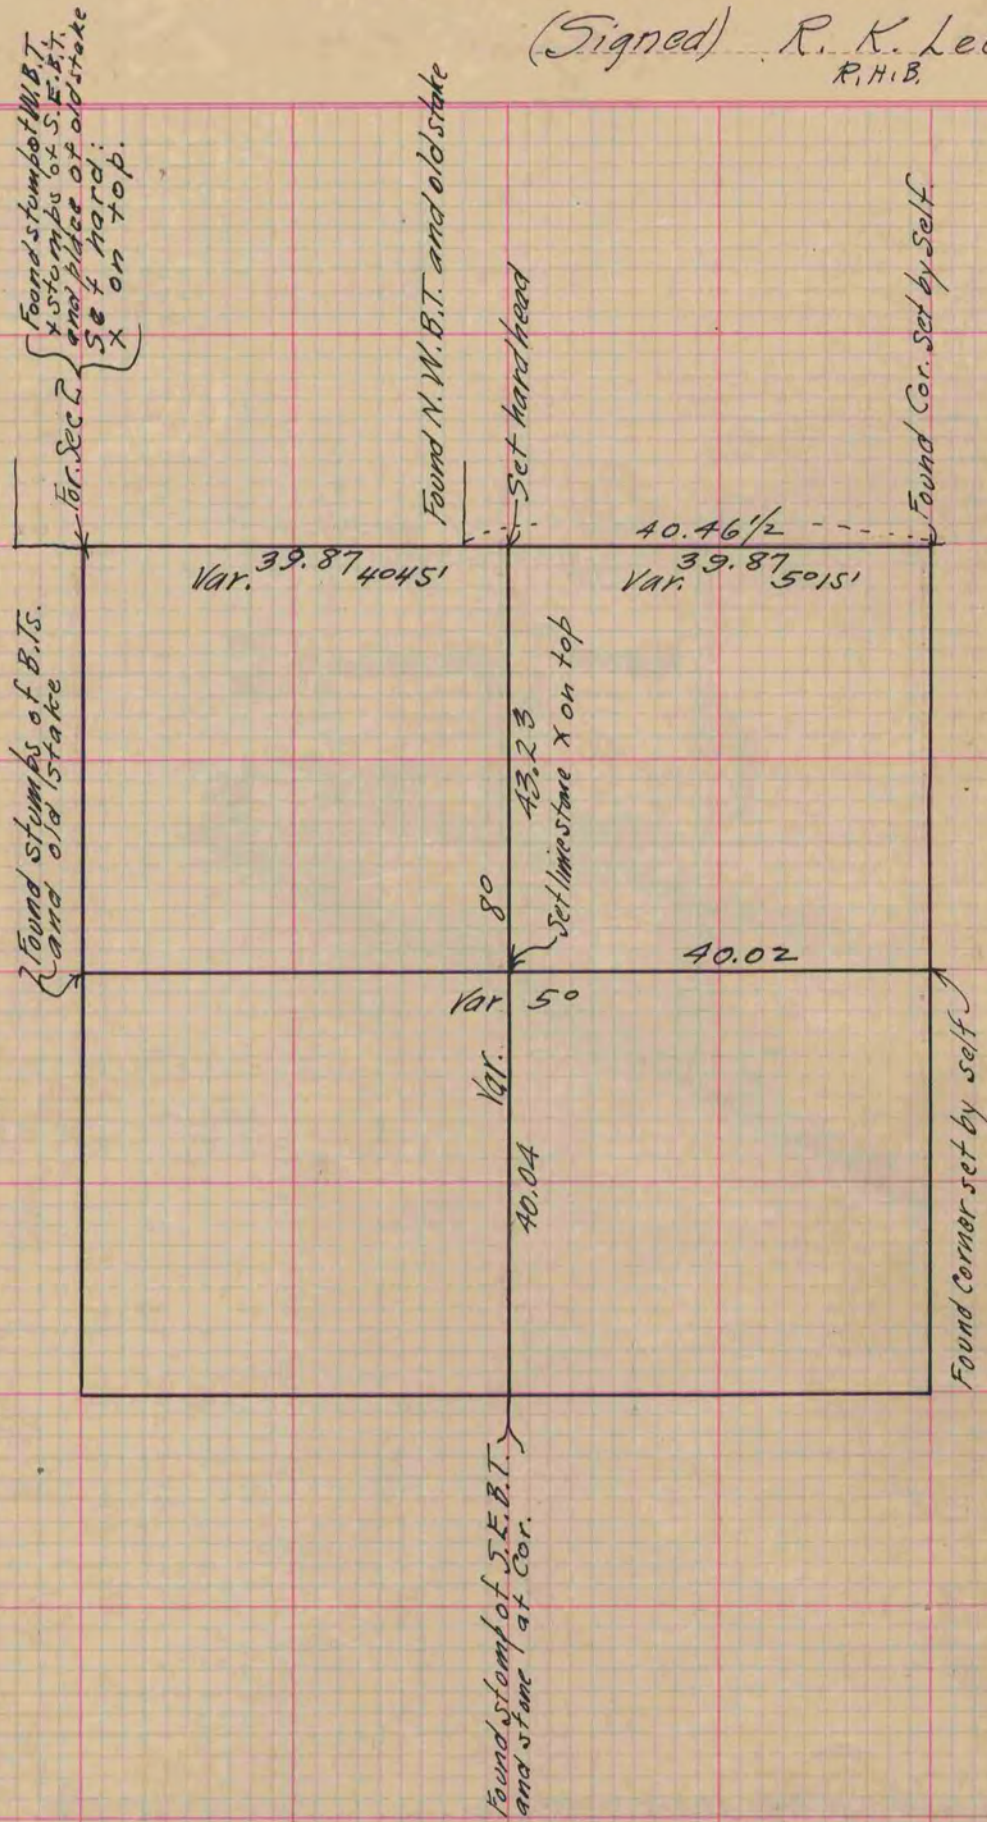

Copied from Upper 1/2 of Page 10 Vol. 2 Original County Surveyors Record