


Of a Survey on Section 7 T 4 R 12 E. of the 4 P. M. in Fulton Township

Rock County, Wisconsin, made November the 10 & 11 1871

I hereby certify that the following is a correct record of said survey as made by me.

(Signed) Edward Ruger
R.H.B. County Surveyor.

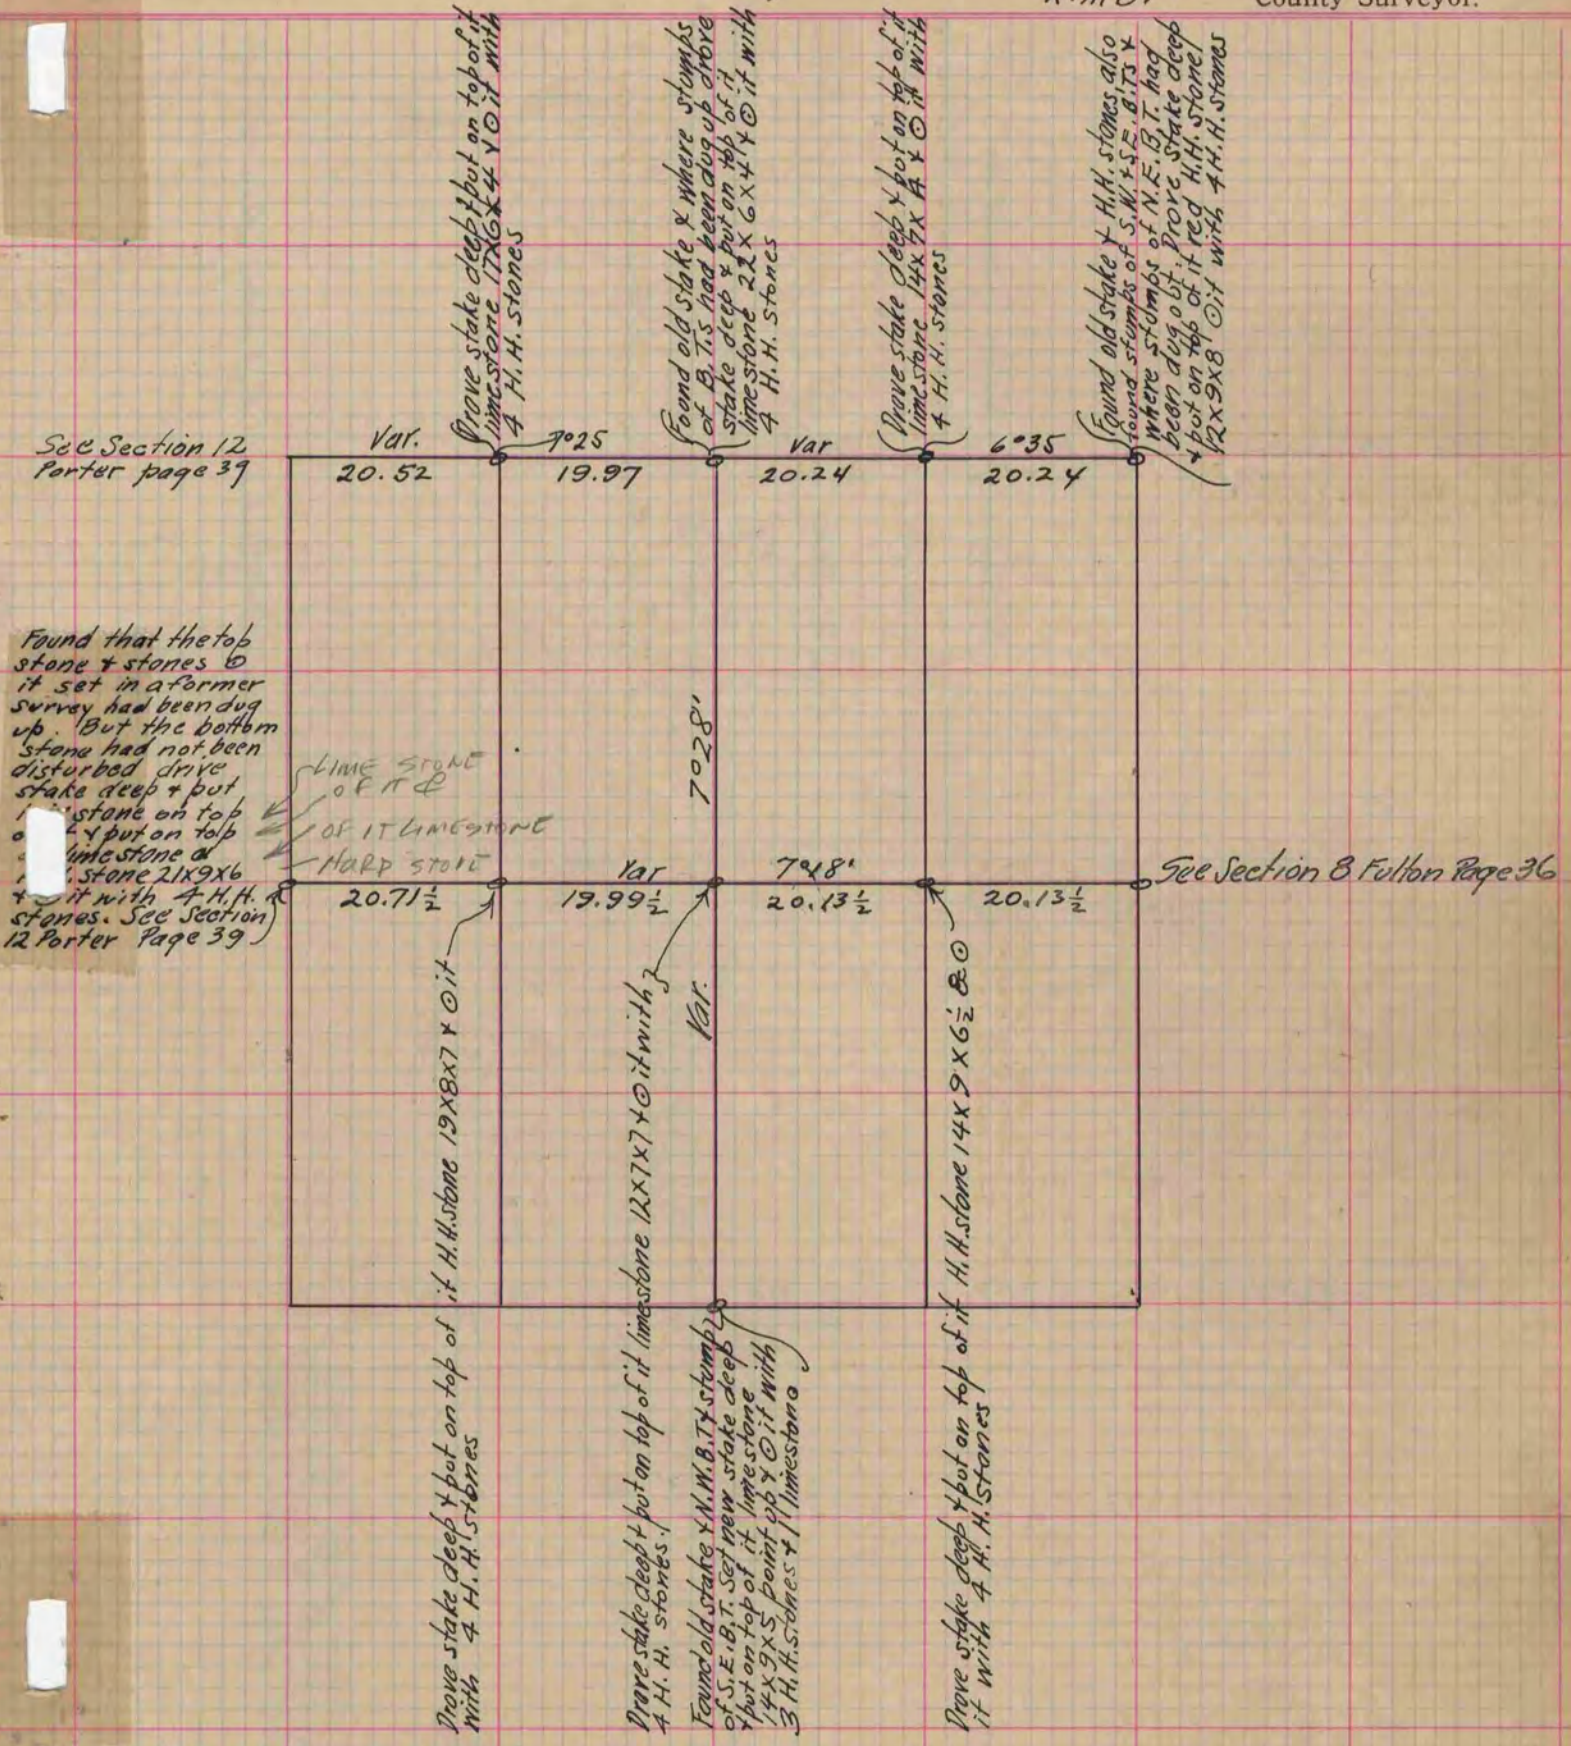

Copied from Page 47 Vol. 2 Original County Surveyors Record