

MICROFILMED

PLAT AND RECORD

COUNTY BUILDING  
CITY OF JANESVILLE


387  
V-2

Of a Survey on Section 2 T 4 R 10 E. of the 4 P. M. in Union Township

Rock County, Wisconsin, made April the 29 1884

I hereby certify that the following is a correct record of said survey as made by me.

(Signed) Edward Ruger  
R.H.B. County Surveyor.

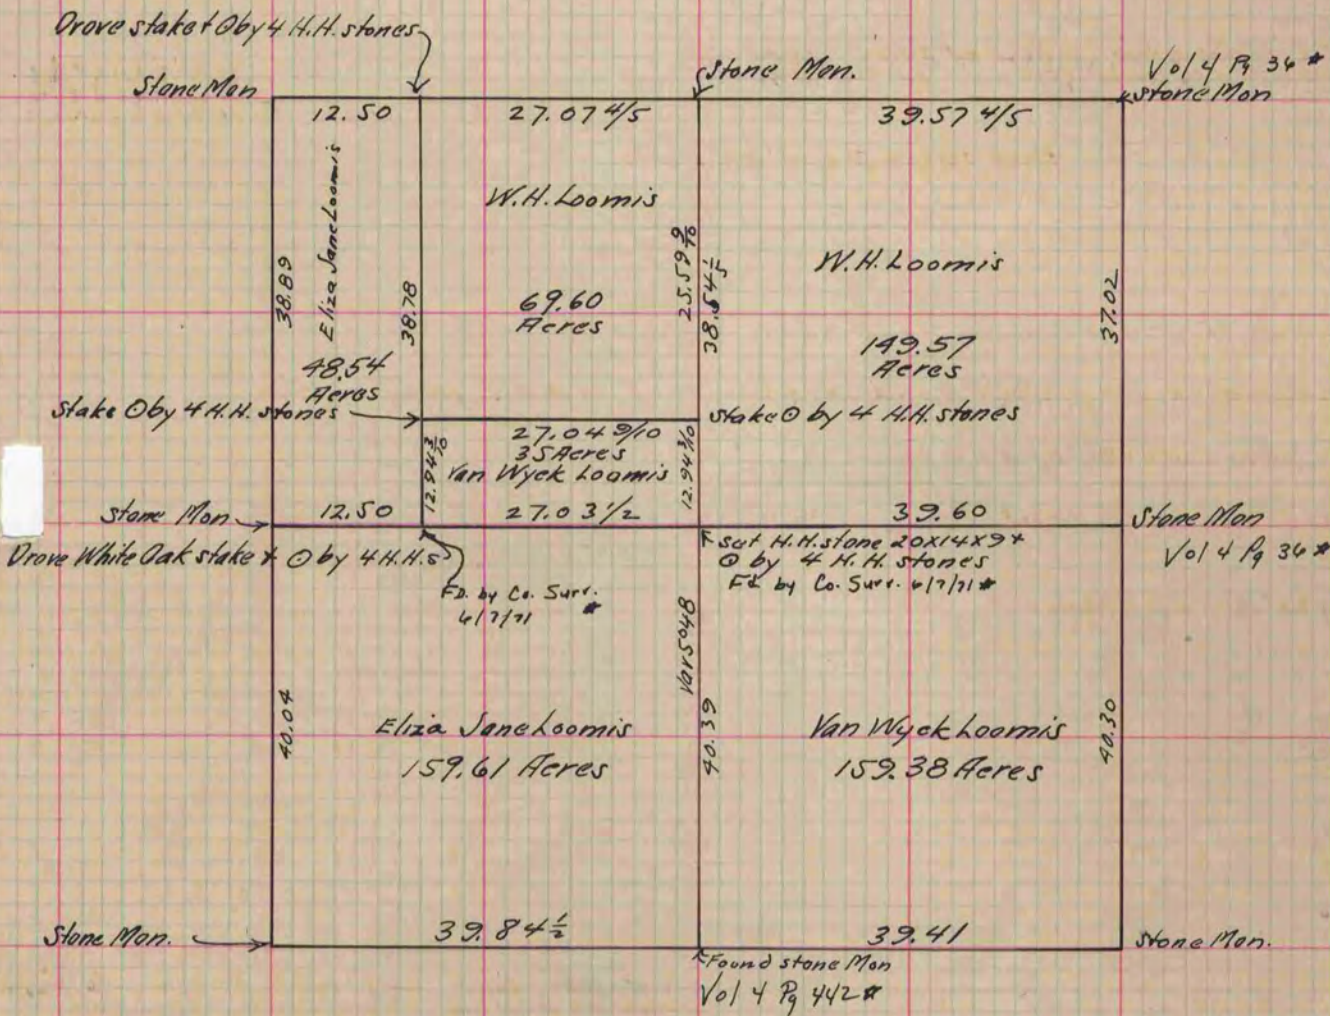

\* Copied from Beloit Records  
12/11/75  
G.G.

Copied from P. 311 Vol. 2 County Surveyors Record.