

MICROFILMED PLAT AND RECORD


Of a Survey on Section 26 T 2 R 14 E. of the 4 P. M. in Bradford Township

Rock County, Wisconsin, made June the 5th 1877

I hereby certify that the following is a correct record of said survey as made by me.

COUNTY BUILDING
CITY OF JANESVILLE

(Signed) Edward Ruger
R. H. S. County Surveyor.

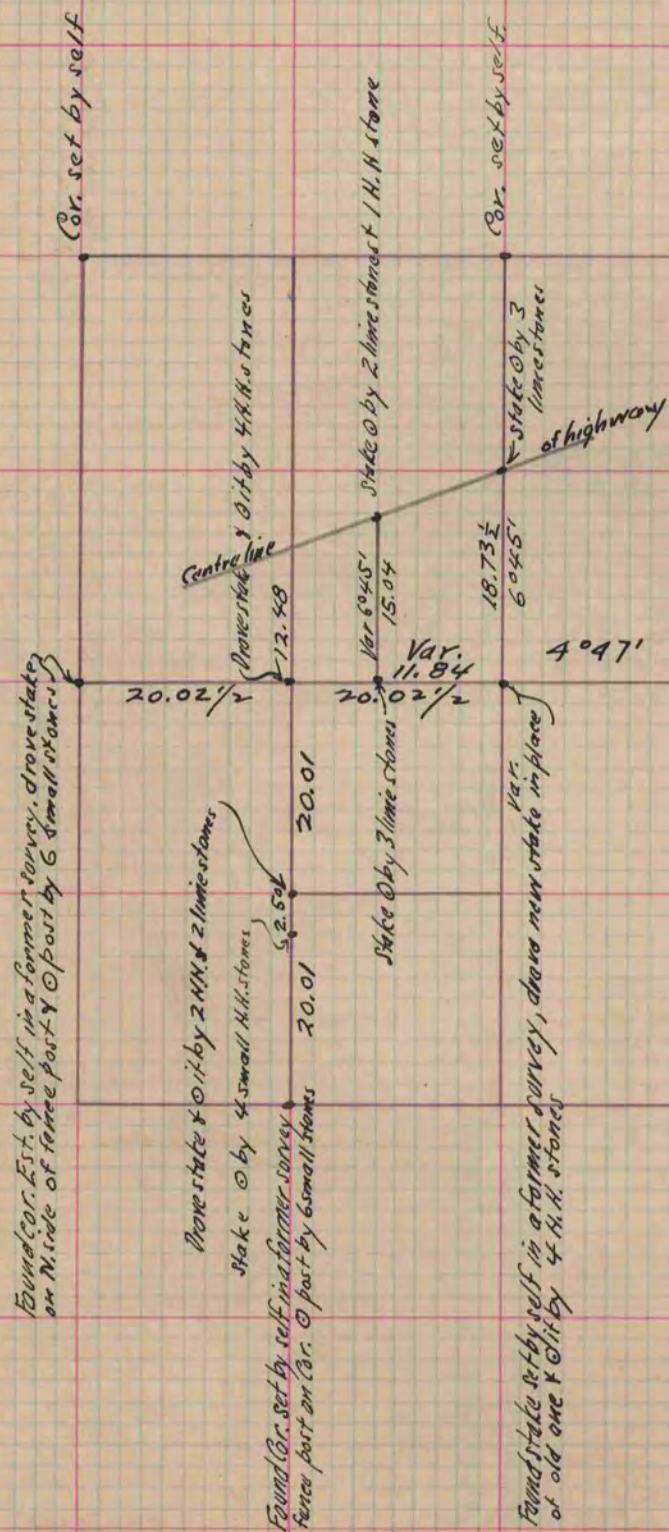

Copied from P. 184 Vol. 2. County Surveyors Record