


Of a Survey on Section 30 T 4 R 14 E. of the 4 P. M. in Lima Township  
 Rock County, Wisconsin, made November the 24 & 25 1871

I hereby certify that the following is a correct record of said survey as made by me.

COUNTY BUILDING  
 CITY OF JANESVILLE

(Signed) Edward Ruger  
 R.H.B.

County Surveyor.

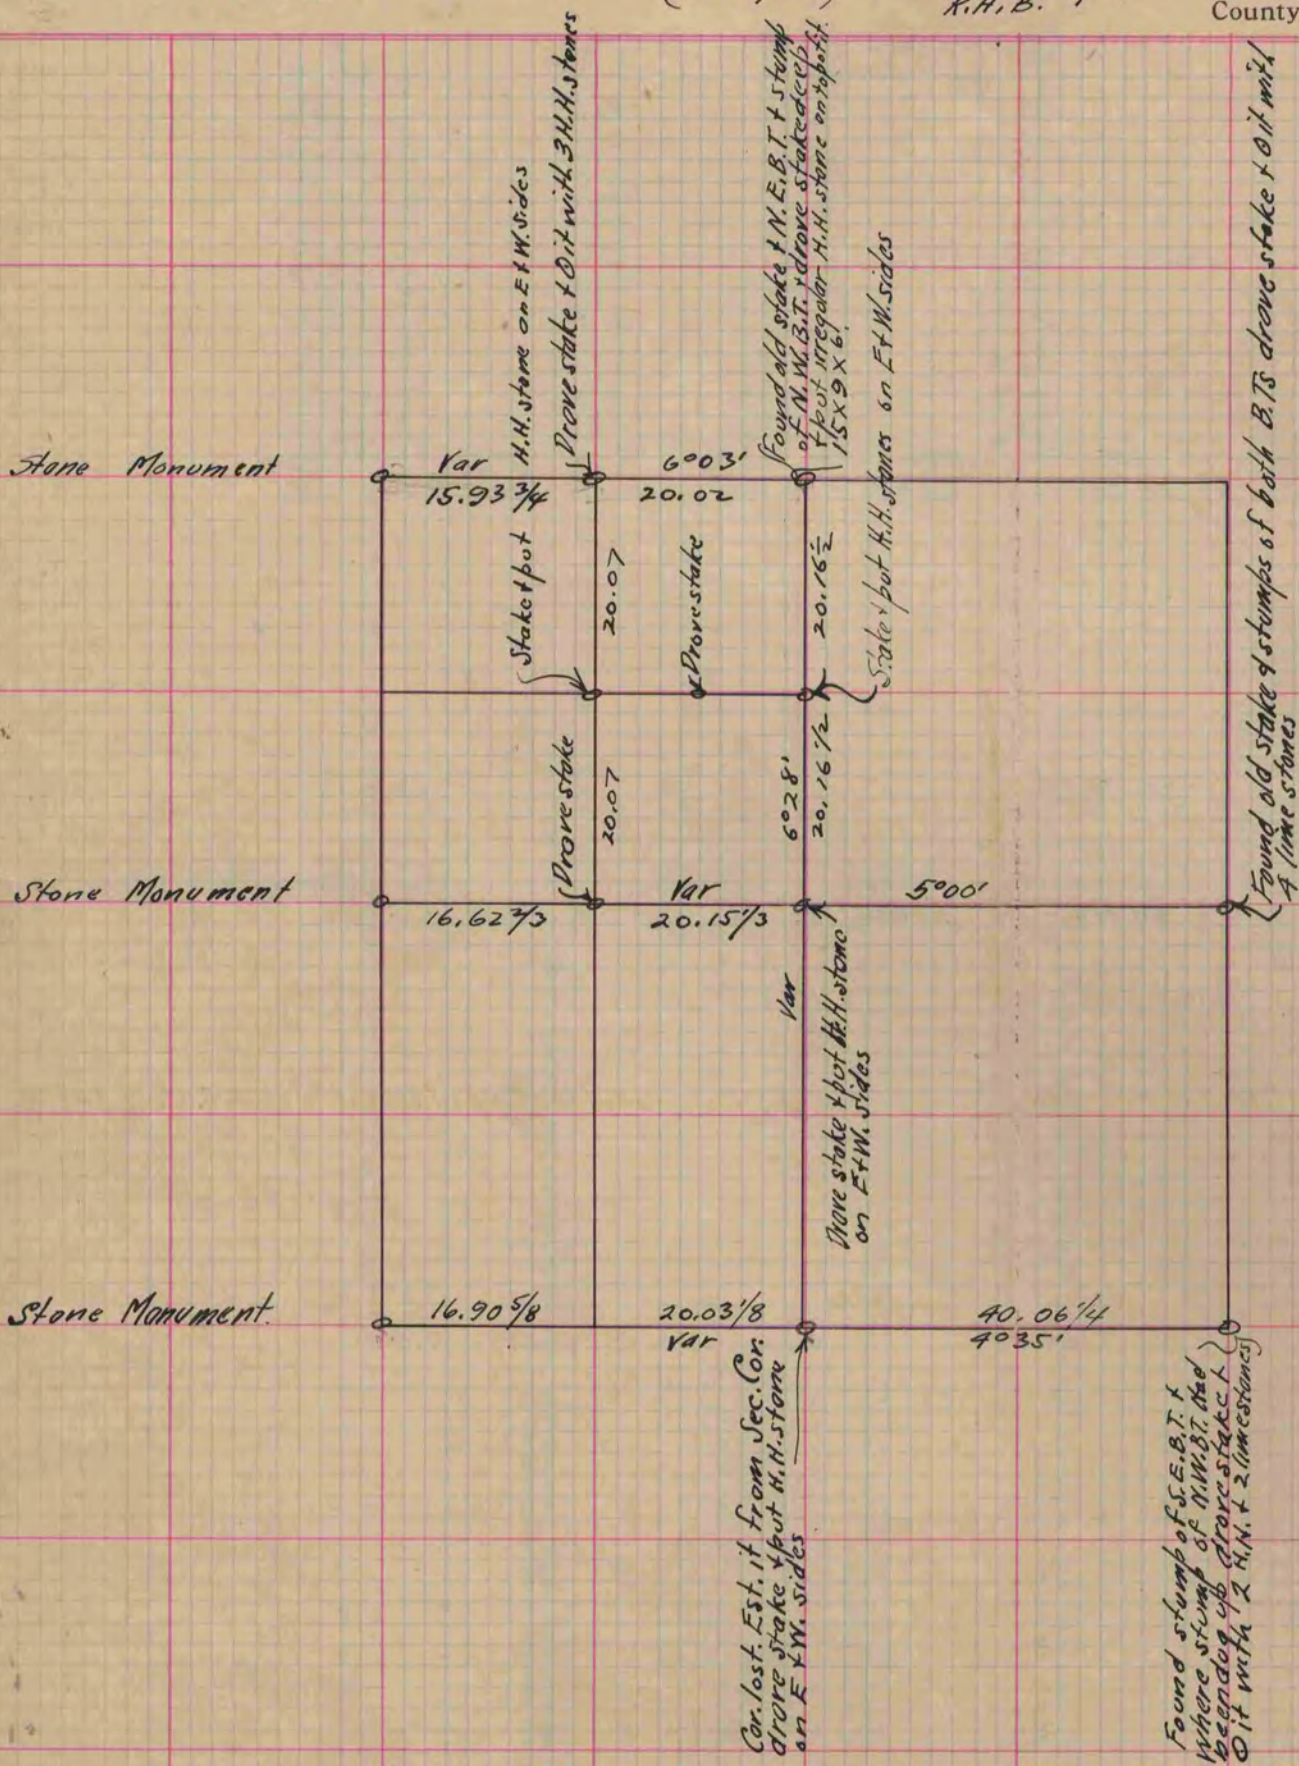

*Copied from page 47 Vol. 2. Original County Surveyors Record*