

382
MICROFILMED

PLAT AND RECORD

Of a Survey on Section 20 T 4 R 14 E. of the 4 P. M. in Lima Township


Rock County, Wisconsin, made July the 1st 1884

I hereby certify that the following is a correct record of said survey as made by me.

COUNTY BUILDING
CITY OF JANESVILLE

(Signed) Edward Ruger
R. H. B. County Surveyor.

Found stake set by Locke & where stump of S.E. B.T. had decayed. Drove new stake & \odot by 3
H.H.s & 1 limestone
Found remains of old stake & N.W. B.T. & stump of
S.W. B.T. drove new stake & \odot by 4 H.H. stones

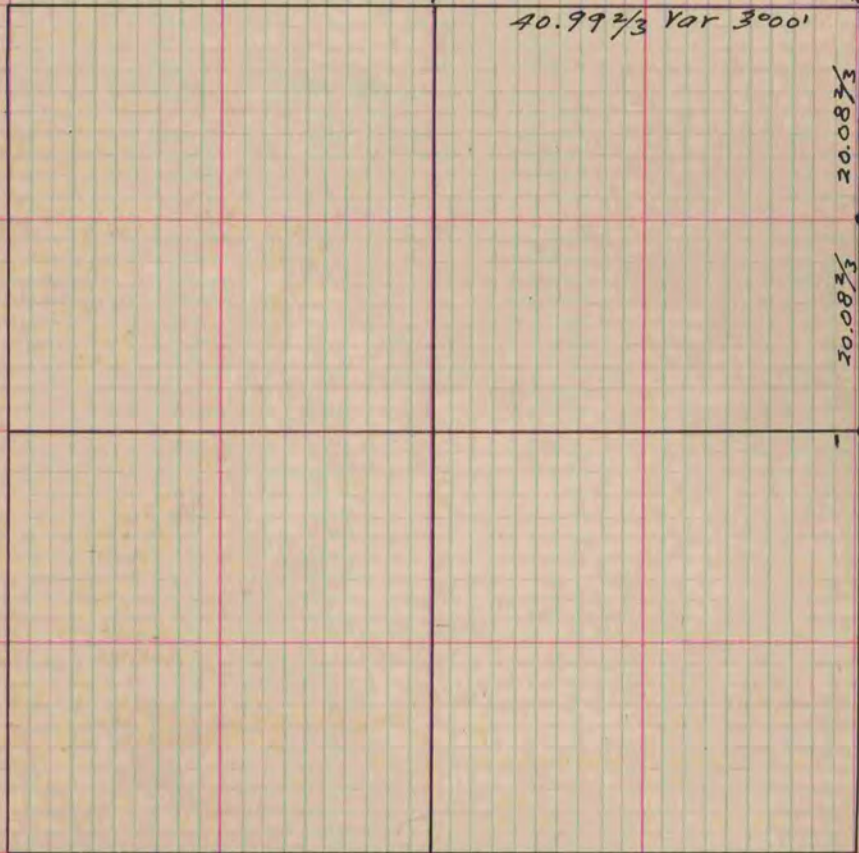

Copied from P. 307 Vol. 2. County Surveyors Record.