

MICROFILMED

PLAT AND RECORD

243

V-1


COUNTY BUILDING
CITY OF JANESVILLE

Of a Survey on Sections 31 + 32 T 4 R 12 E. of the 4 P. M. in Fulton Township

Rock County, Wisconsin, made July the 20th + 21st 1865

I hereby certify that the following is a correct record of said survey as made by me.

(Signed) S. D. Locke
R. H. B. County Surveyor.

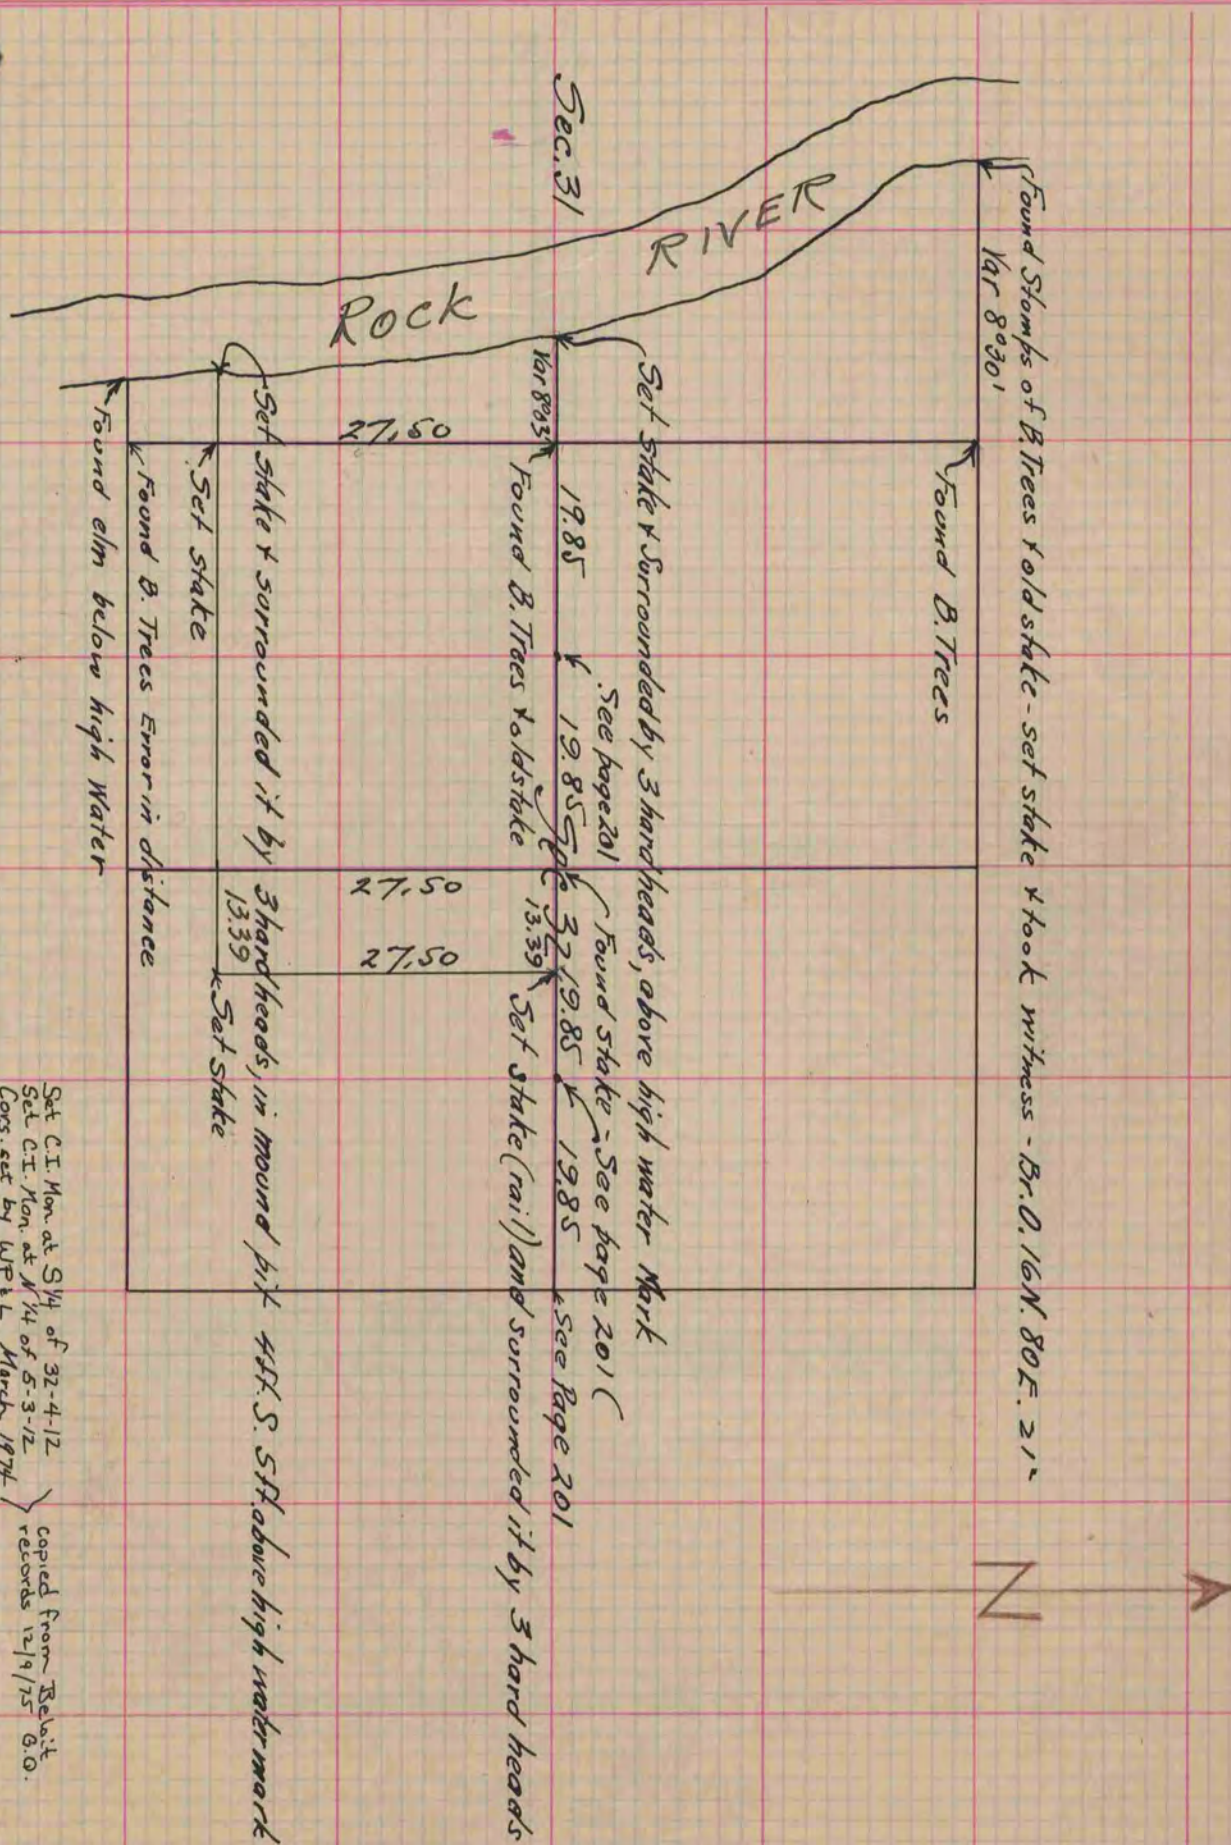

Copied from Page 223 Vol. 1. Original County Surveyors Record