

CITY OF JANESVILLE
COUNTY BUILDING

PLAT AND RECORD

421
V-4

COUNTY BUILDING
CITY OF JANESVILLE

Of a Survey on Section 5 T 4 R 11 E. of the 4 P. M. in PORTER Township


Rock County, Wisconsin, made MAY the 20 1969

I hereby certify that the following is a correct record of said survey as made by me.

MICROFILMED

W. H. Batts

County Surveyor.

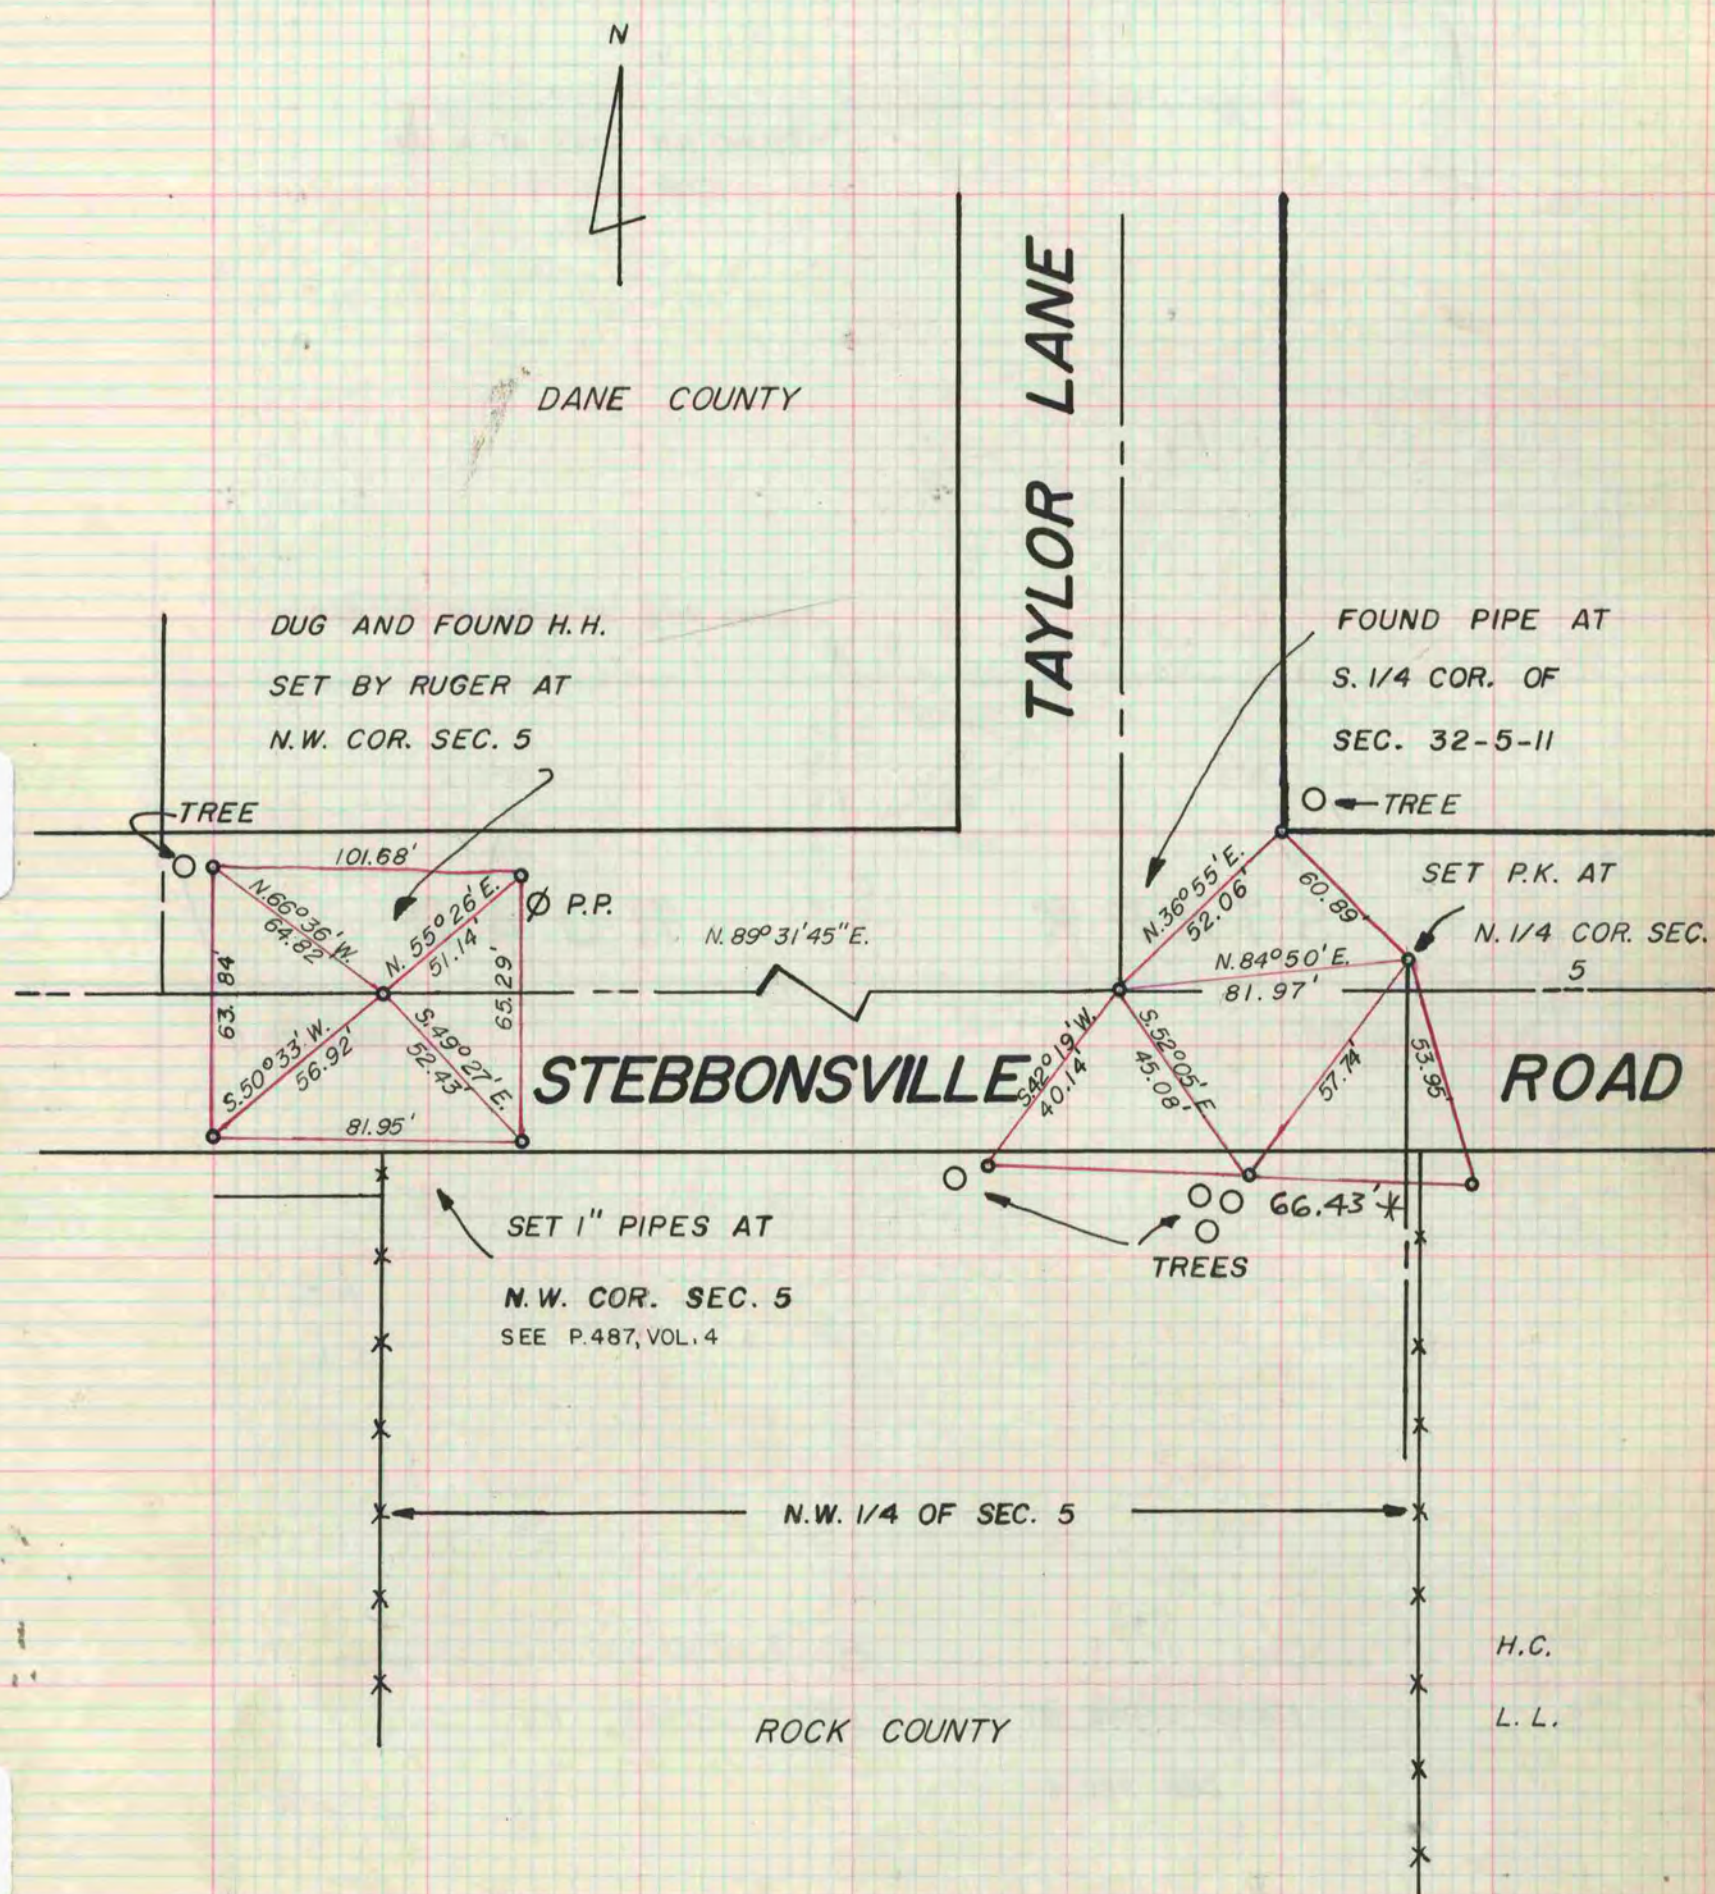

*COPIED FROM BELOIT REC 12/11/75 DAB
ALL BEARINGS ARE ASTRONOMIC NORTH BEARINGS