

# PLAT AND RECORD

V-4

Of a Survey on Section <sup>29-30</sup> ~~31-32~~ T. **3 N.** R. **11 E.** of the 4 P. M. in **CENTER** Township

Rock County, Wisconsin, made **APRIL** the **10th** 19**67**


I hereby certify that the following is a correct record of said survey as made by me.

*R. B. Batten*

County Surveyor.

**MICROFILMED**

**COUNTY BUILDING  
CITY OF JANESVILLE**

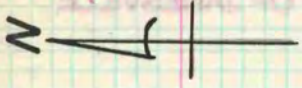

N. 1/4 Cor. Sec. 32

H.C.  
O.S.

**ROAD**

1320 ±

**POINT**

DUG LARGE HOLE AT ALL 3 COR.

FOUND NOTHING

1320 ±

**MINERAL**

N.W. Cor. Sec. 32

**LONE ROCK ROAD**

