

PLAT AND RECORD

MICROFILMED


COUNTY BUILDING
CITY OF JANESVILLE

Of a Survey on Section 6 T 3 R 10 E. of the 4 P. M. in Magnolia Township

Rock County, Wisconsin, made October the 25th 1890

I hereby certify that the following is a correct record of said survey as made by me.

(Signed) O. G. Bleodorn Dep.
R. H. B. County Surveyor.

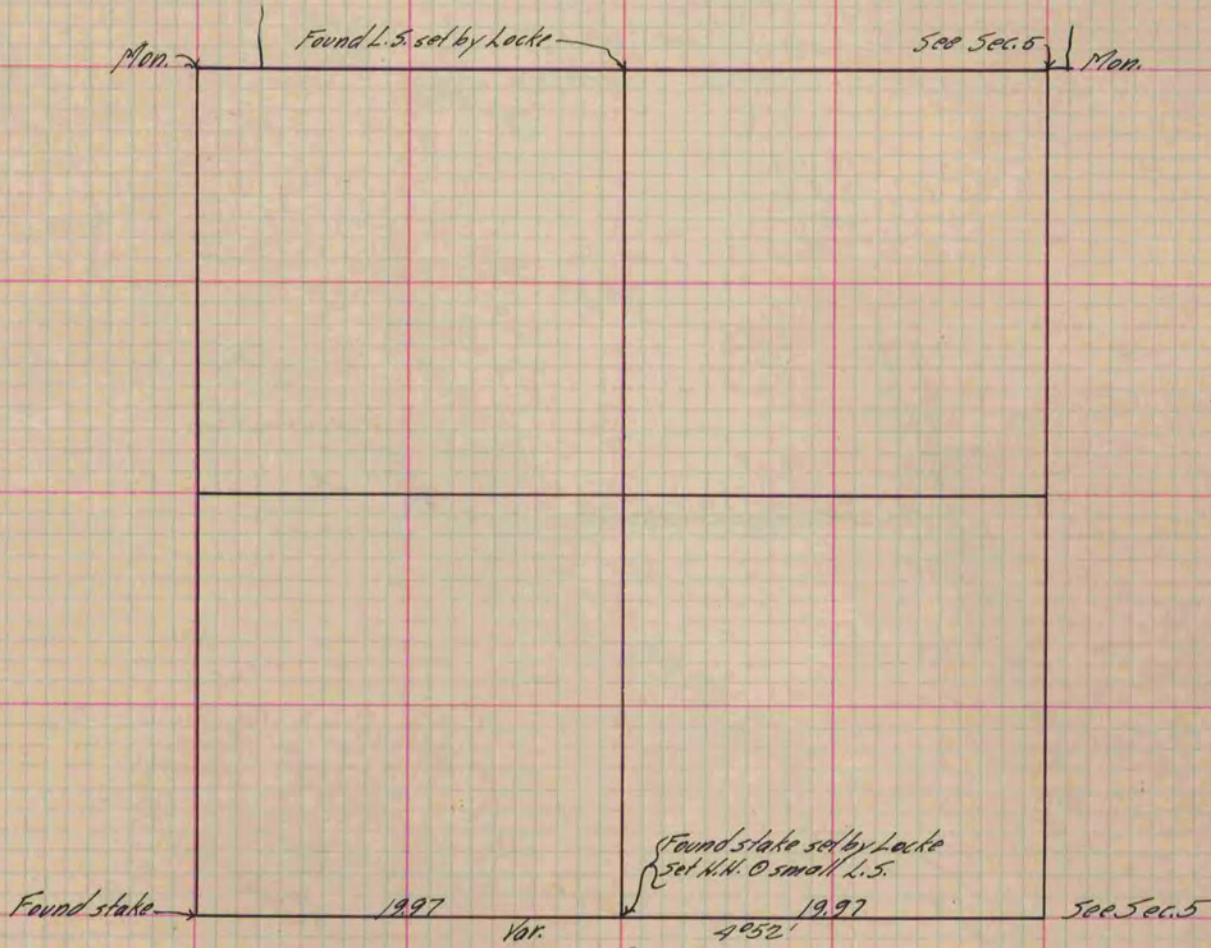

Copied from P. 353 Vol. 2 County Surveyor's Record.