

PLAT AND RECORD

MICROFILMED


COUNTY BUILDING
CITY OF JANESVILLE

Of a Survey on Section 20 + 21 T 4 R 10 E. of the 4 P. M. in Union Township

Rock County, Wisconsin, made Jan. 23 + 24 1890 + July the 13 - 1893

I hereby certify that the following is a correct record of said survey as made by me.

(Signed) O. G. Bleedorn Dep.
R. H. B. County Surveyor.

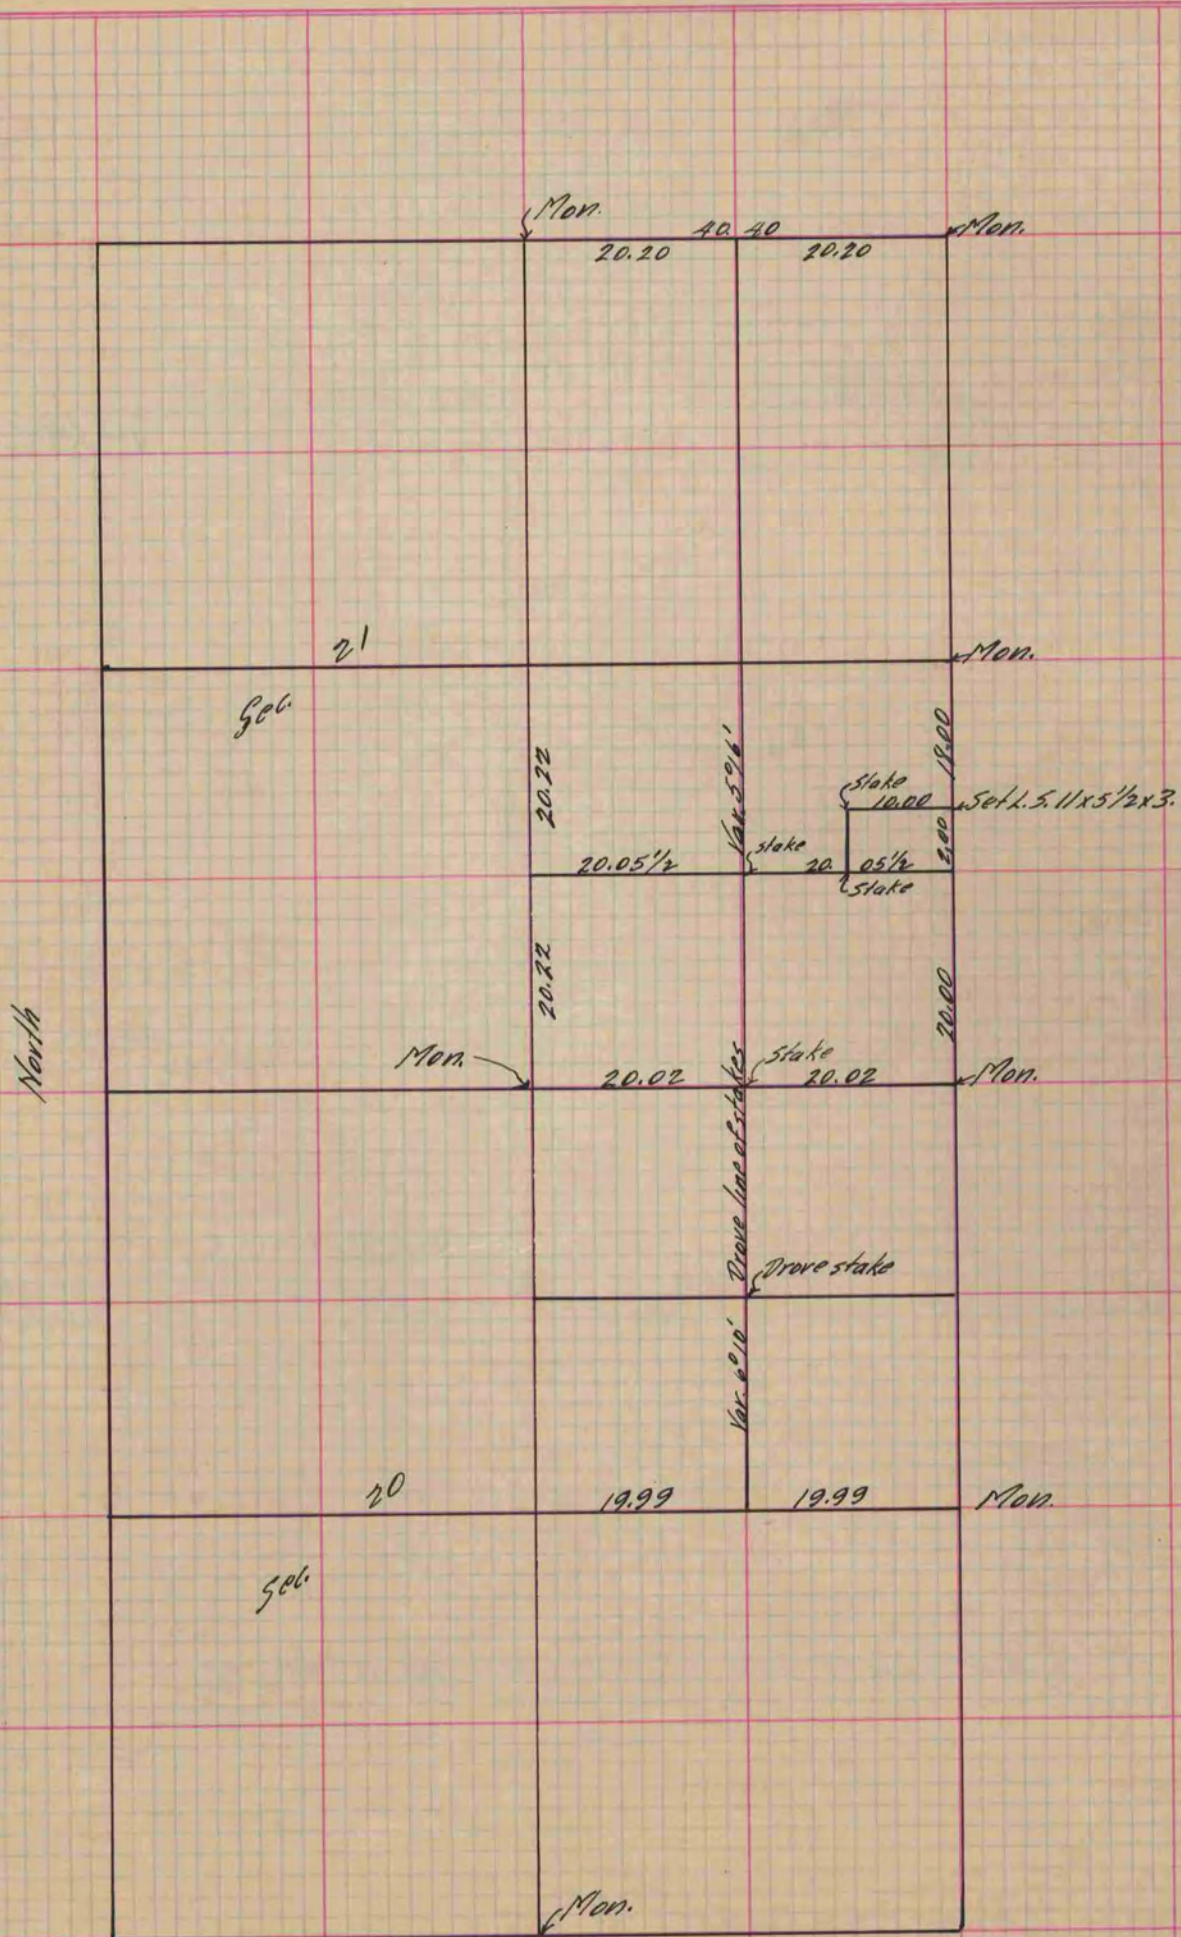

Copied from P. 347 Vol. 2 County Surveyors' Record.