

PLAT AND RECORD

MICROFILMED


COUNTY BUILDING
CITY OF JANESVILLE

Of a Survey on ^{S.E. 1/4} Section 27 T 2 R 12 E. of the 4 P. M. in Rock Township

Rock County, Wisconsin, made November the 21st 1887

I hereby certify that the following is a correct record of said survey as made by me.

(Signed) Edward Ruger
R.H.B. County Surveyor.

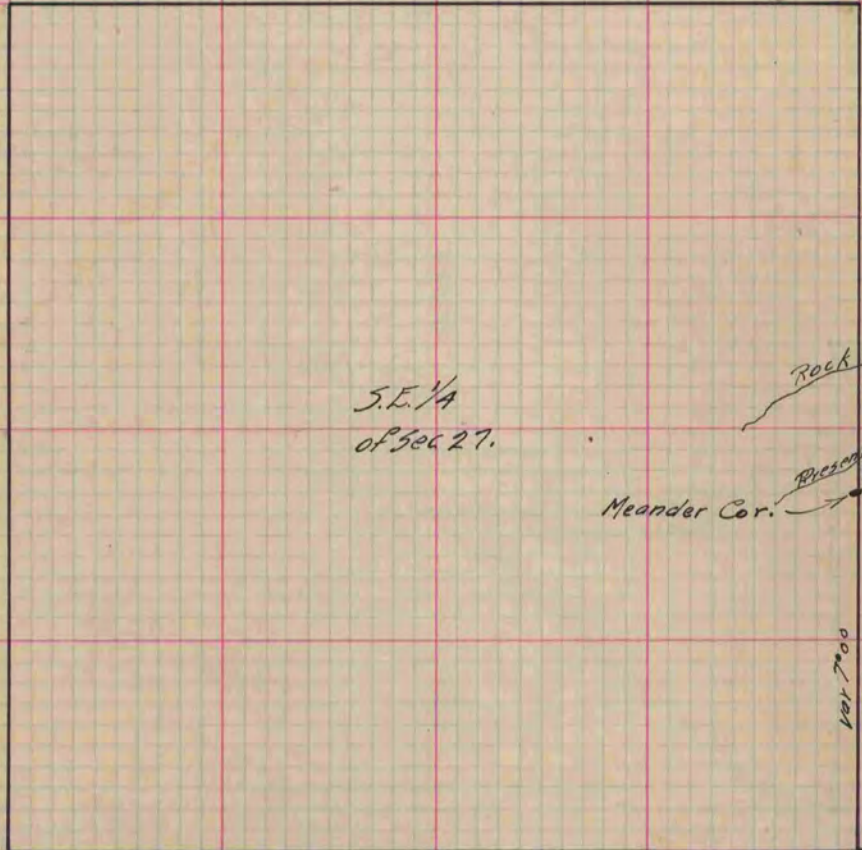

Copied from P. 334 Vol. 2 County Surveyors Record.