

MICROFILMED

PLAT AND RECORD


Of a Survey on Section 4 T 3 R 13 E. of the 4 P. M. in Harmony Township

Rock County, Wisconsin, made November the 16th 1870

I hereby certify that the following is a correct record of said survey as made by me.

COUNTY BUILDING
CITY OF JANESVILLE

(Signed) Edward Ruger of Dept. R.H.B. County Survey

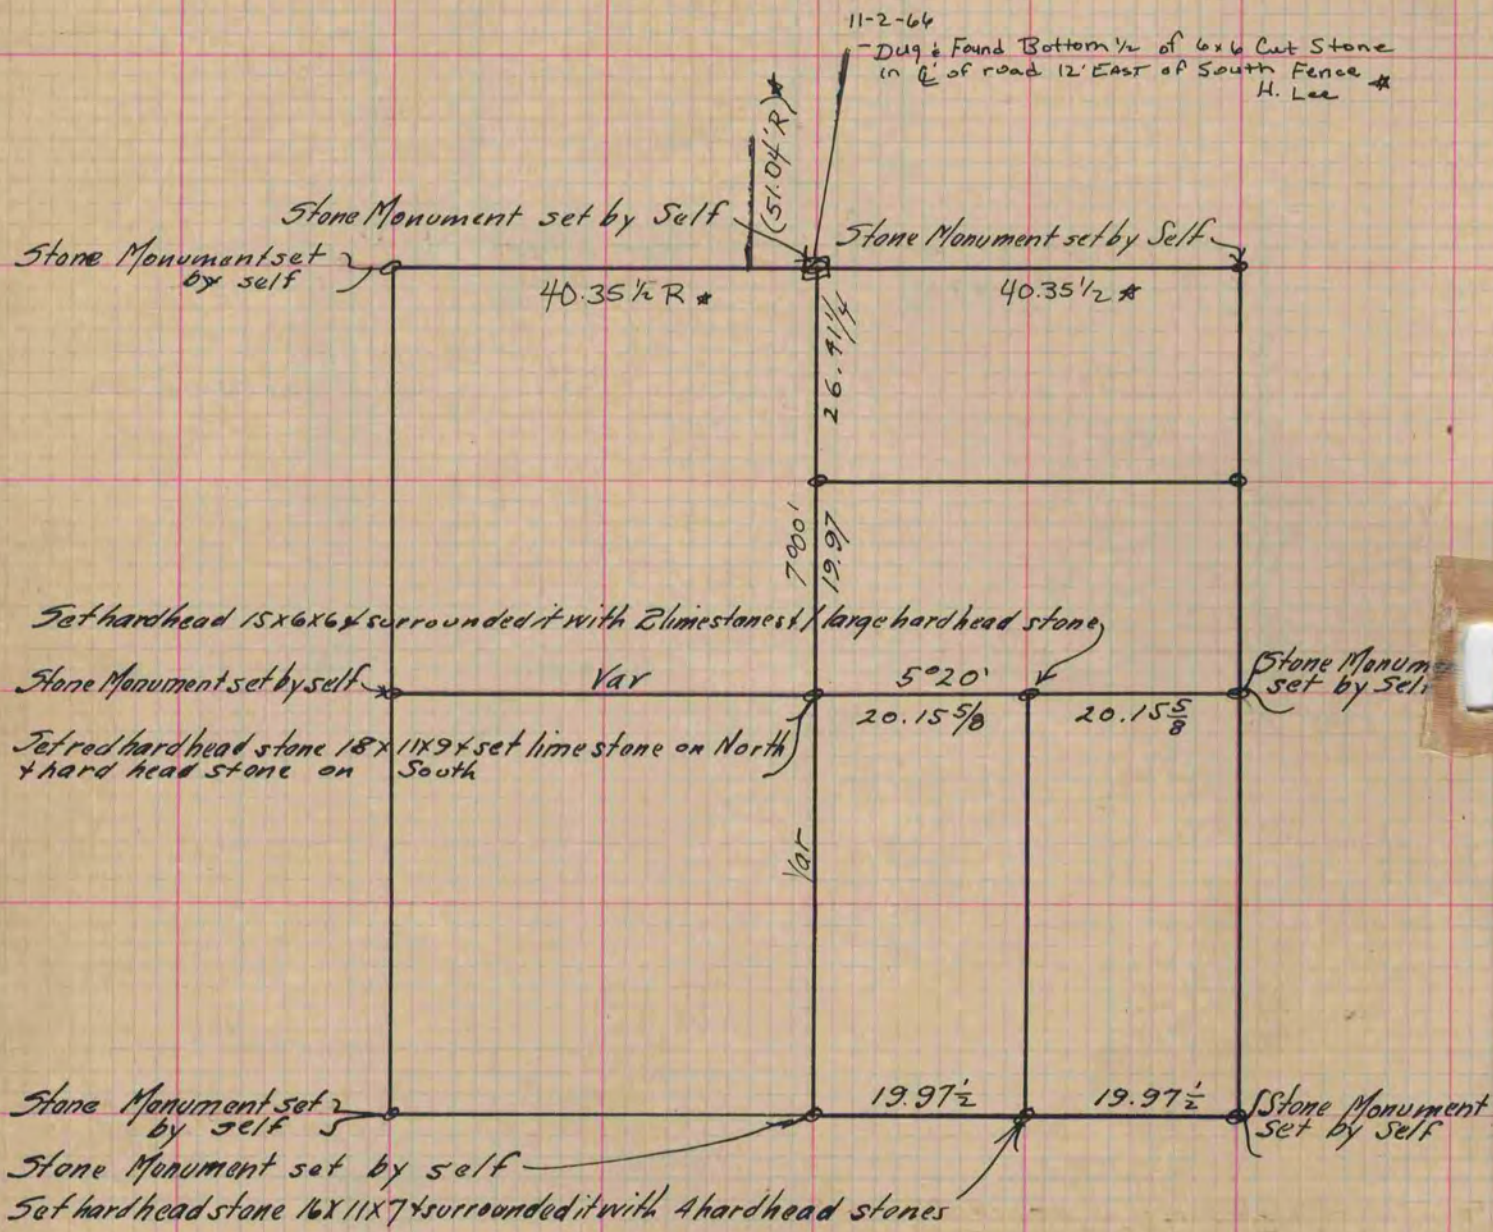

* Copied from Beloit records 12/10/75 G.Q.

Copied from page 29 Vol. 2 Original County Surveyors Record