

# PLAT AND RECORD



COUNTY BUILDING  
CITY OF JANESVILLE

Of a Survey on Section 18 T 3 N R 11 E. of the 4 P. M. in CENTER Township

Rock County, Wisconsin, made NOV the 30

I hereby certify that the following is a correct record of said survey as made by me.

**MICROFILMED**

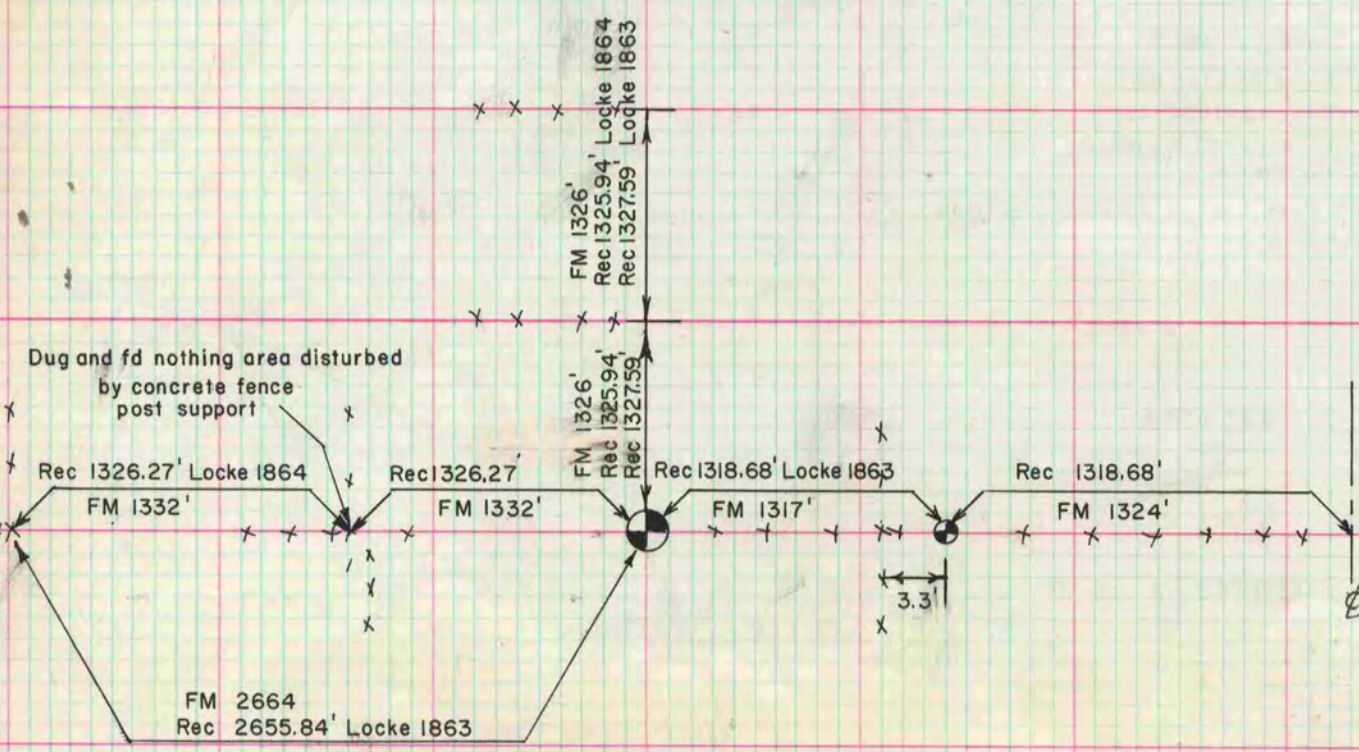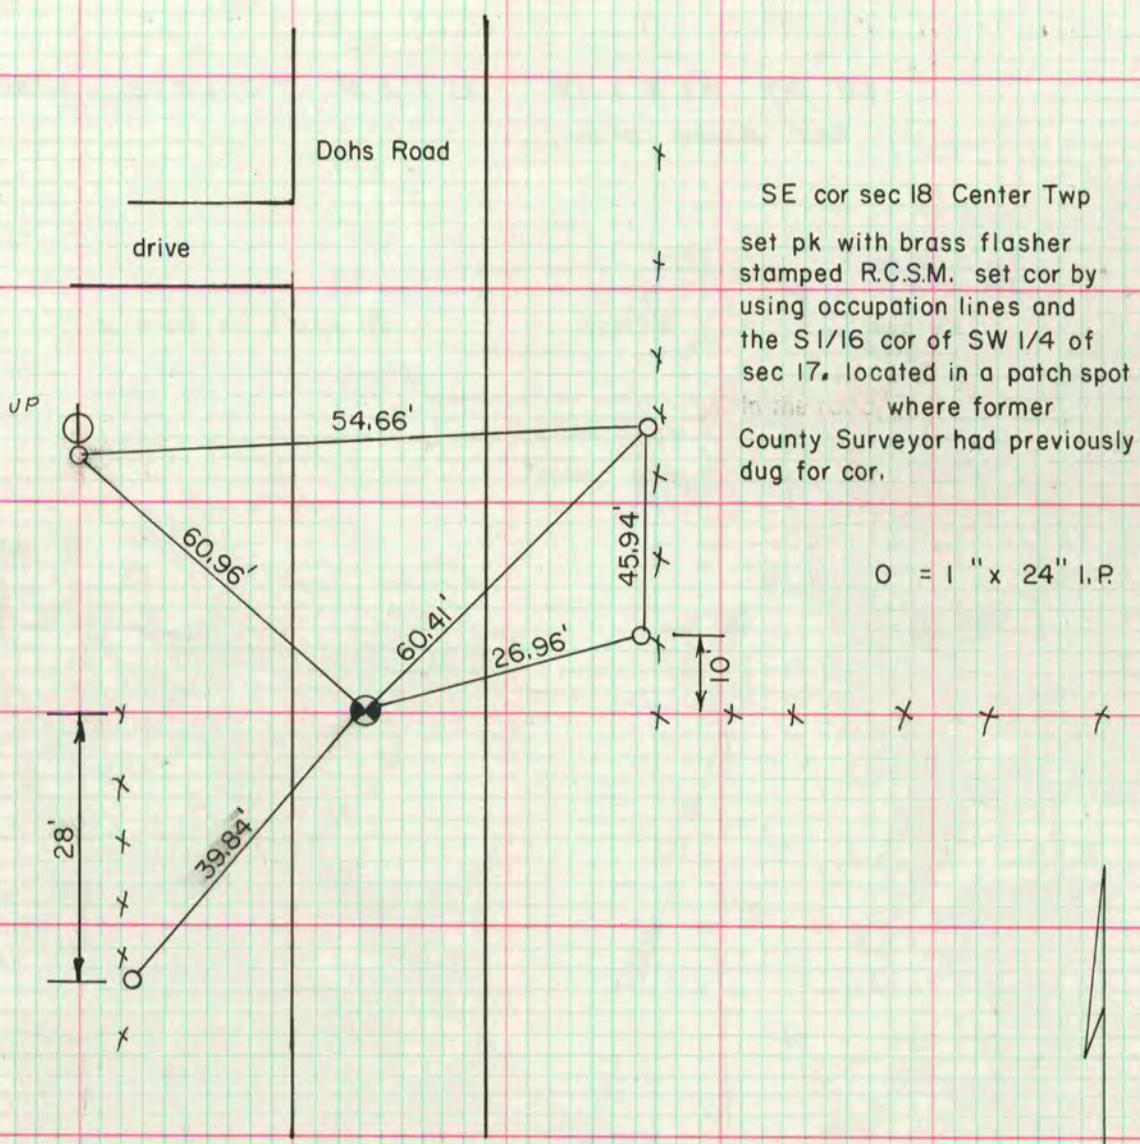

FM 2664  
Rec 2655.84' Locke 1863