


Of a Survey on Section 35 T 3 R 14 E. of the 4 P. M. in JOHNSTOWN Township
 Rock County, Wisconsin, made OCT the 21 19 05

I hereby certify that the following is a correct record of said survey as made by me.

COUNTY BUILDING
 CITY OF JANESVILLE

EDWARD RUGER
 County Surveyor.

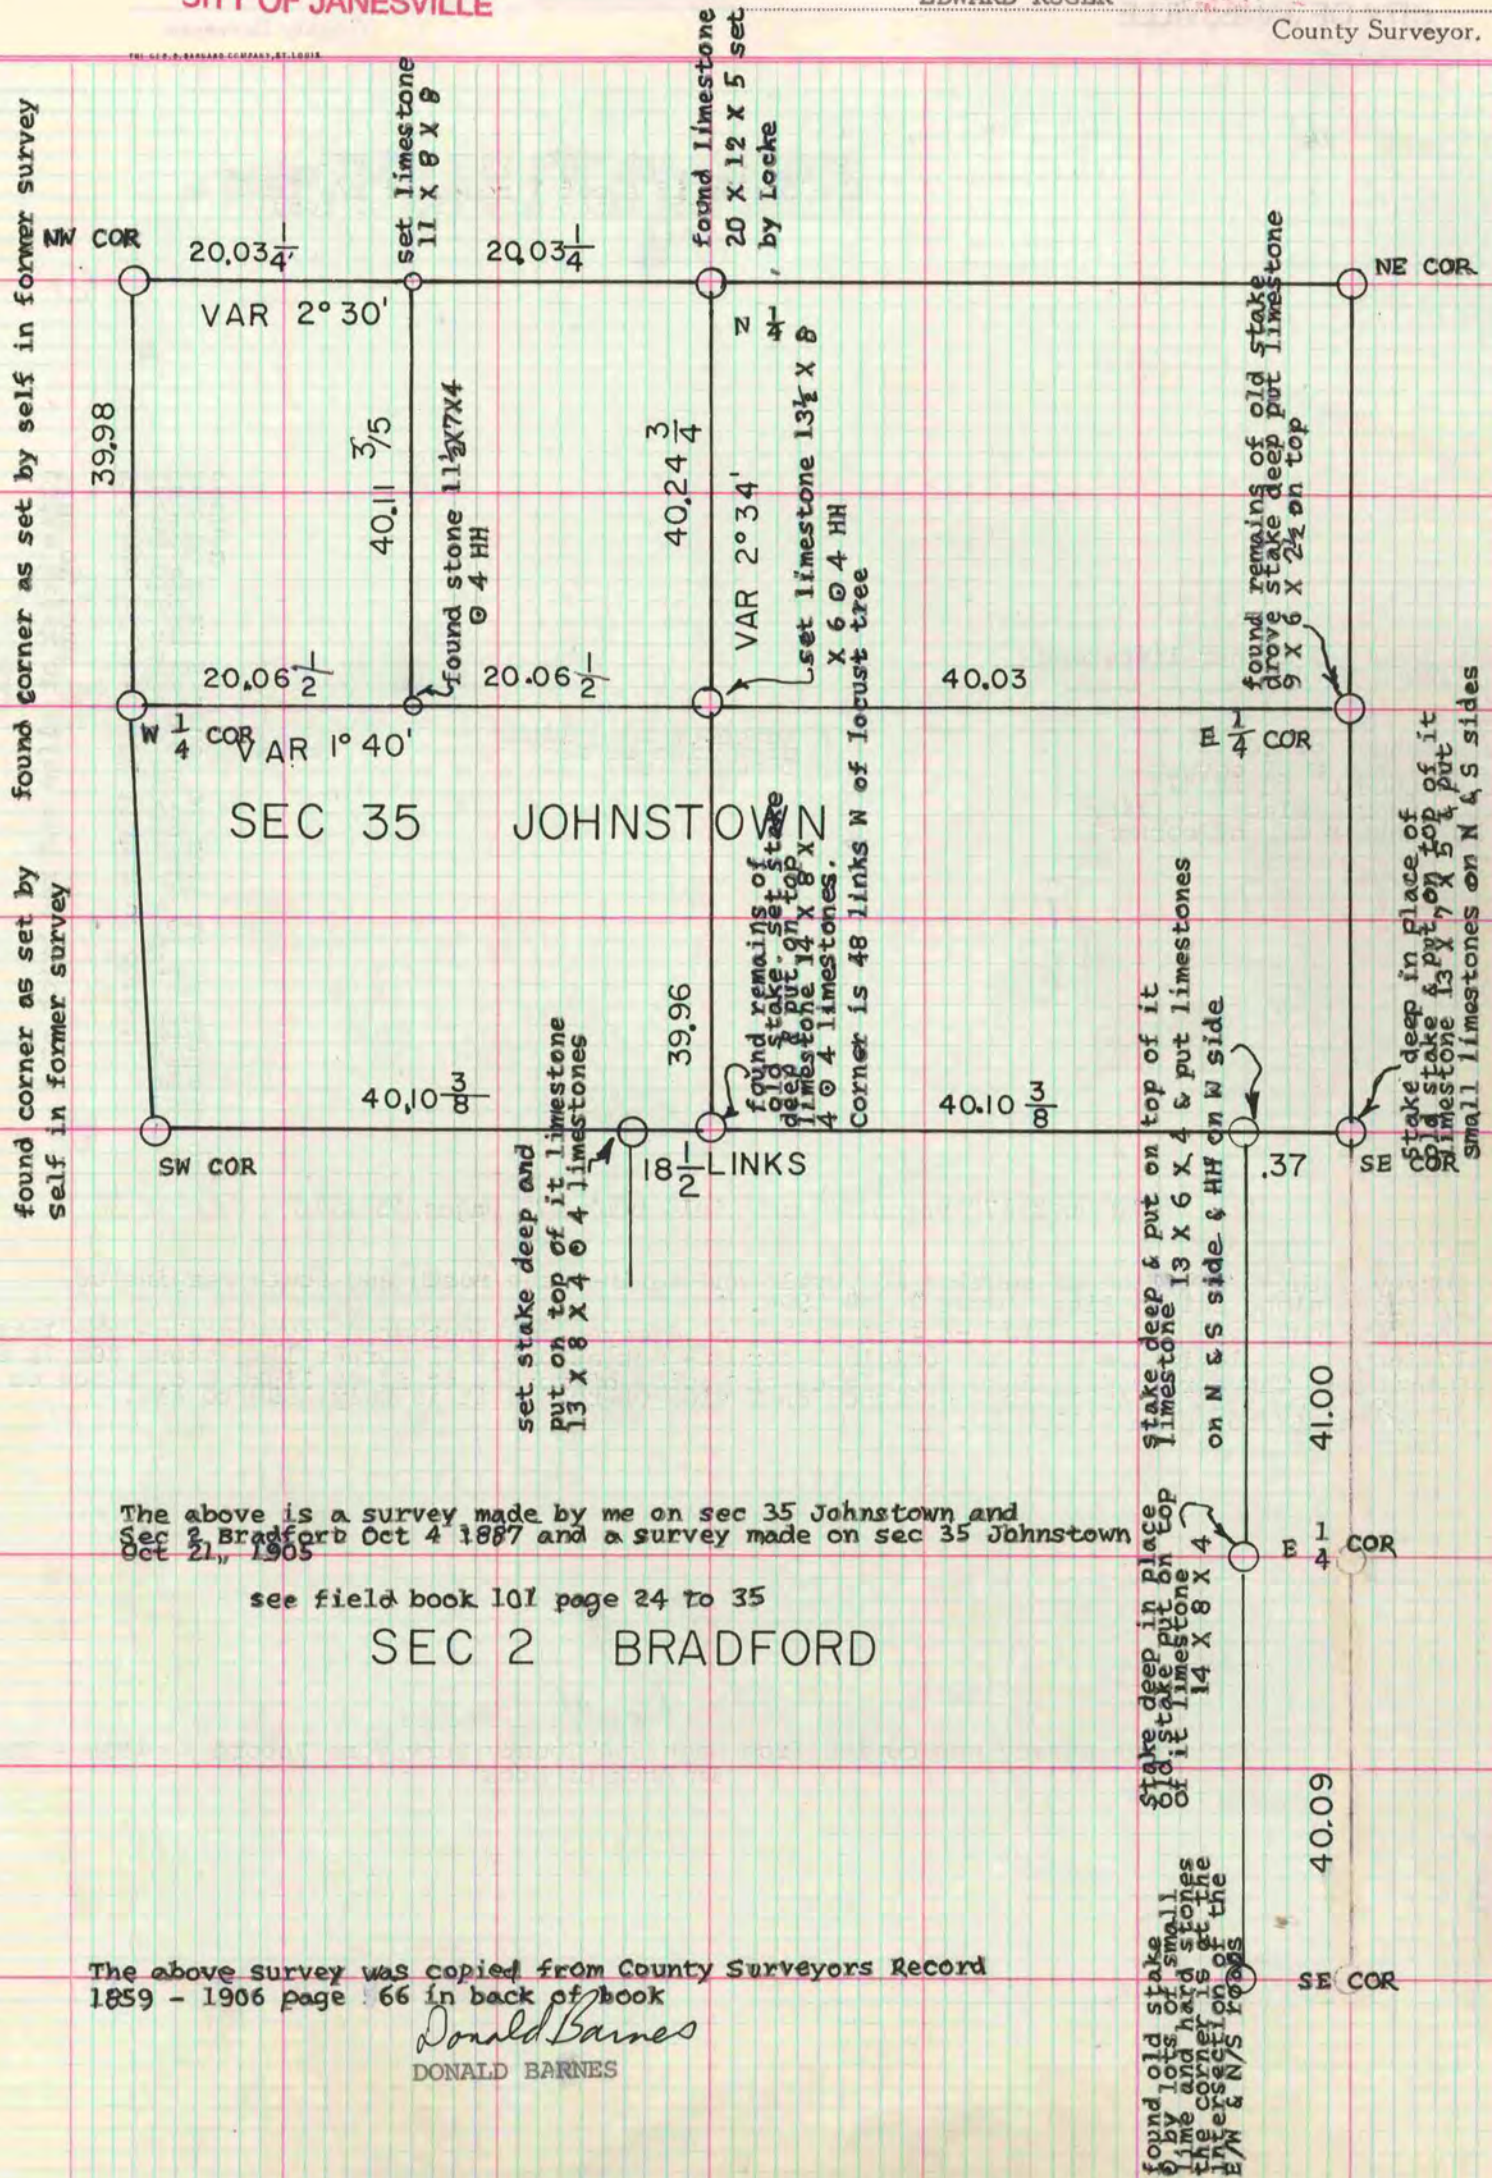

The above is a survey made by me on sec 35 Johnstown and
 Sec 2 Bradford Oct 4 1887 and a survey made on sec 35 Johnstown
 Oct 21, 1905
 see field book 101 page 24 to 35

SEC 2 BRADFORD

The above survey was copied from County Surveyors Record
 1859 - 1906 page 66 in back of book
 Donald Barnes
 DONALD BARNES