

312 VOL. 5 PLAT AND RECORD

Of a Survey on Section 30 T 3 R 12 E. of the 4 P. M. in JANESVILLE Township  
Rock County, Wisconsin, made AUG the 5

I hereby certify that the following is a correct record of said survey as made by me.

COUNTY BUILDING  
CITY OF JANESVILLE


Donald

Baines

County Surveyor.



NW cor sec 30-3-12  
fd 1" I.P. as set by R.H. Batterman Jr.  
1968.

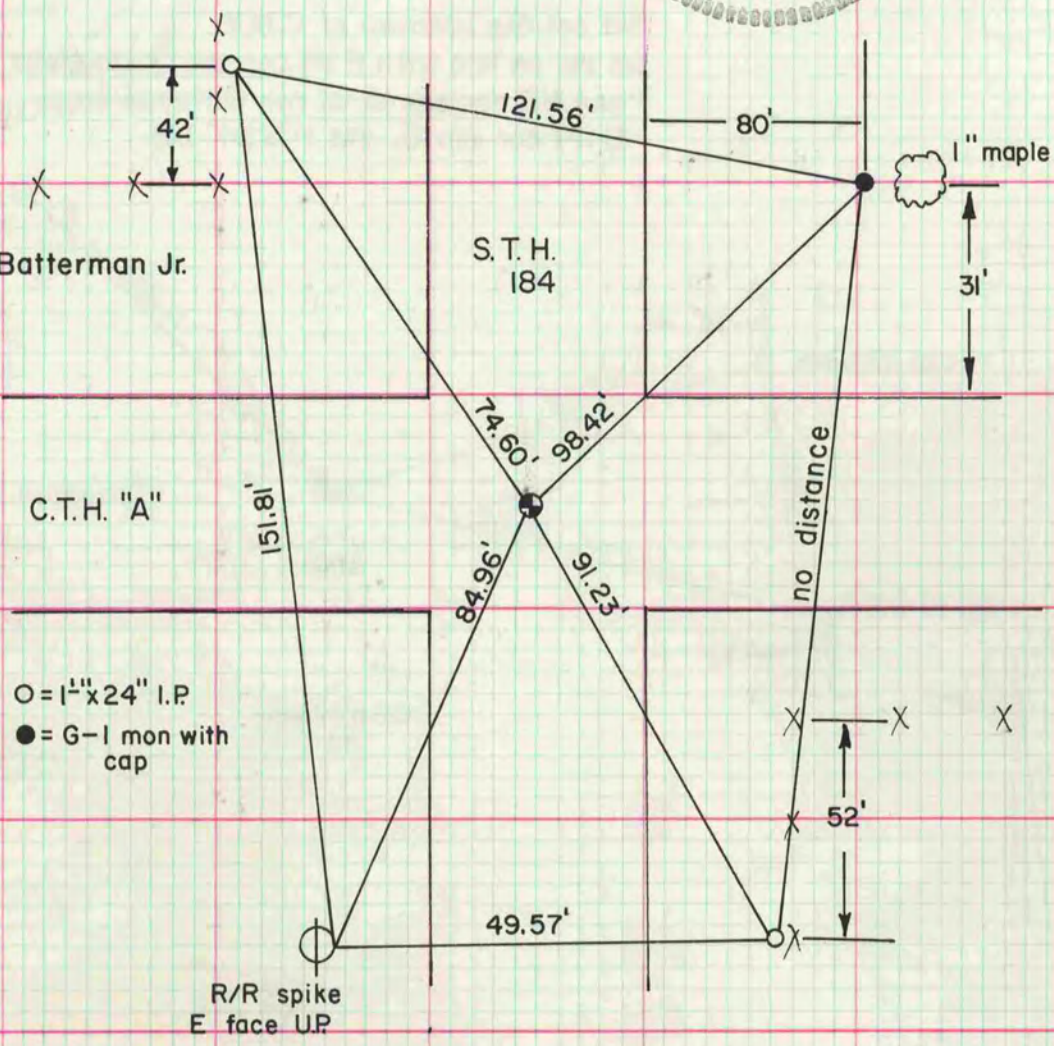

C.T.H. "A"

S.T.H.  
184

O = 1" x 24" I.P.  
● = 6" iron mon with cap

R/R spike  
E face UP



MICROFILMED