

# PLAT AND RECORD

**MICROFILMED**


COUNTY BUILDING  
CITY OF JANESVILLE

Of a Survey on <sup>51.1/4</sup> Section 1 T A R 12 E. of the 4 P. M. in Fulton Township

Rock County, Wisconsin, made Sept. the 6 1899

I hereby certify that the following is a correct record of said survey as made by me.

(Signed) Perry F. Brown  
R.H.B. County Surveyor.

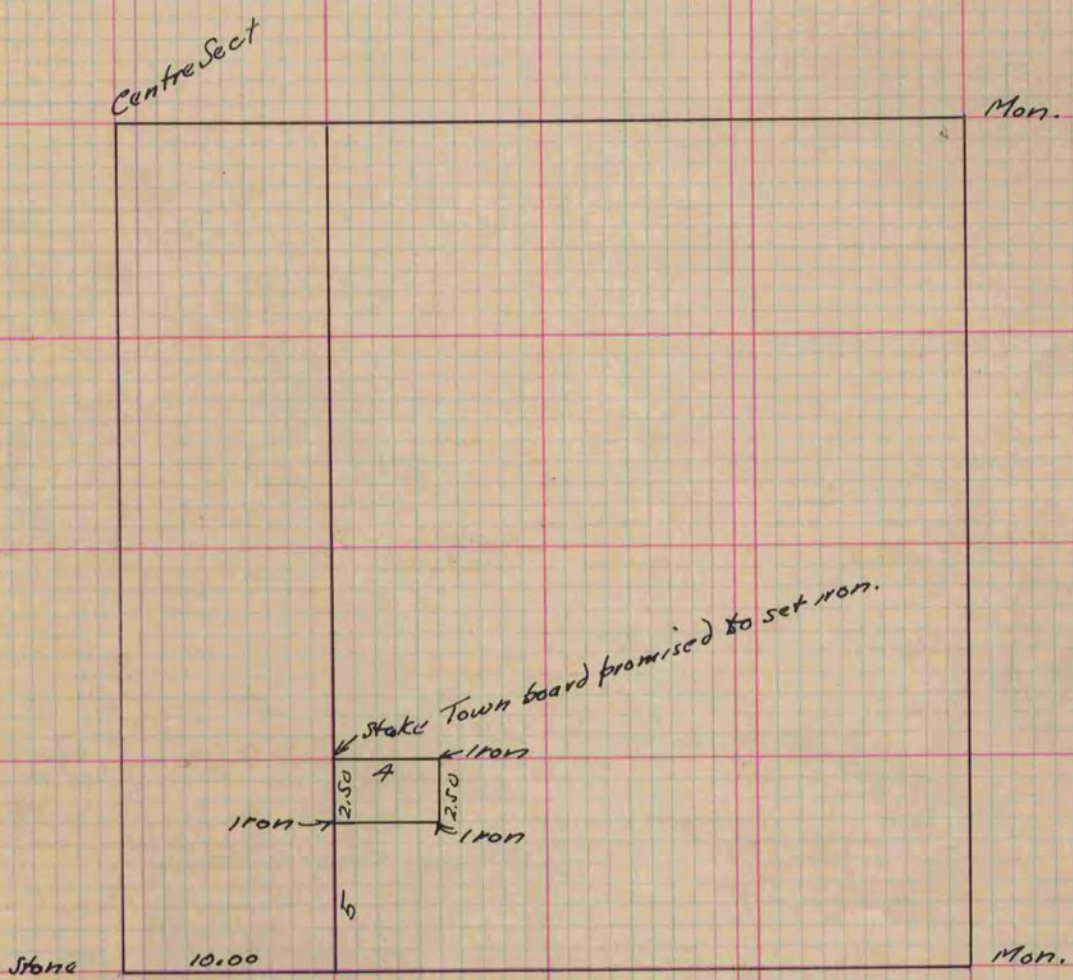

Copied from P. 388 Vol. 2 County Surveyors Record.