

512
V-3

PLAT AND RECORD

COUNTY BUILDING
CITY OF JANESVILLE

Of a Survey on Section 36 T. 3 N R. 10 E. of the 4 P. M. in MAGNOLIA Township


Rock County, Wisconsin, made MARCH 29 to the APRIL 2 1957

MICROFILMED

I hereby certify that the following is a correct record of said survey as made by me.

R. B. Batteman

County Surveyor.

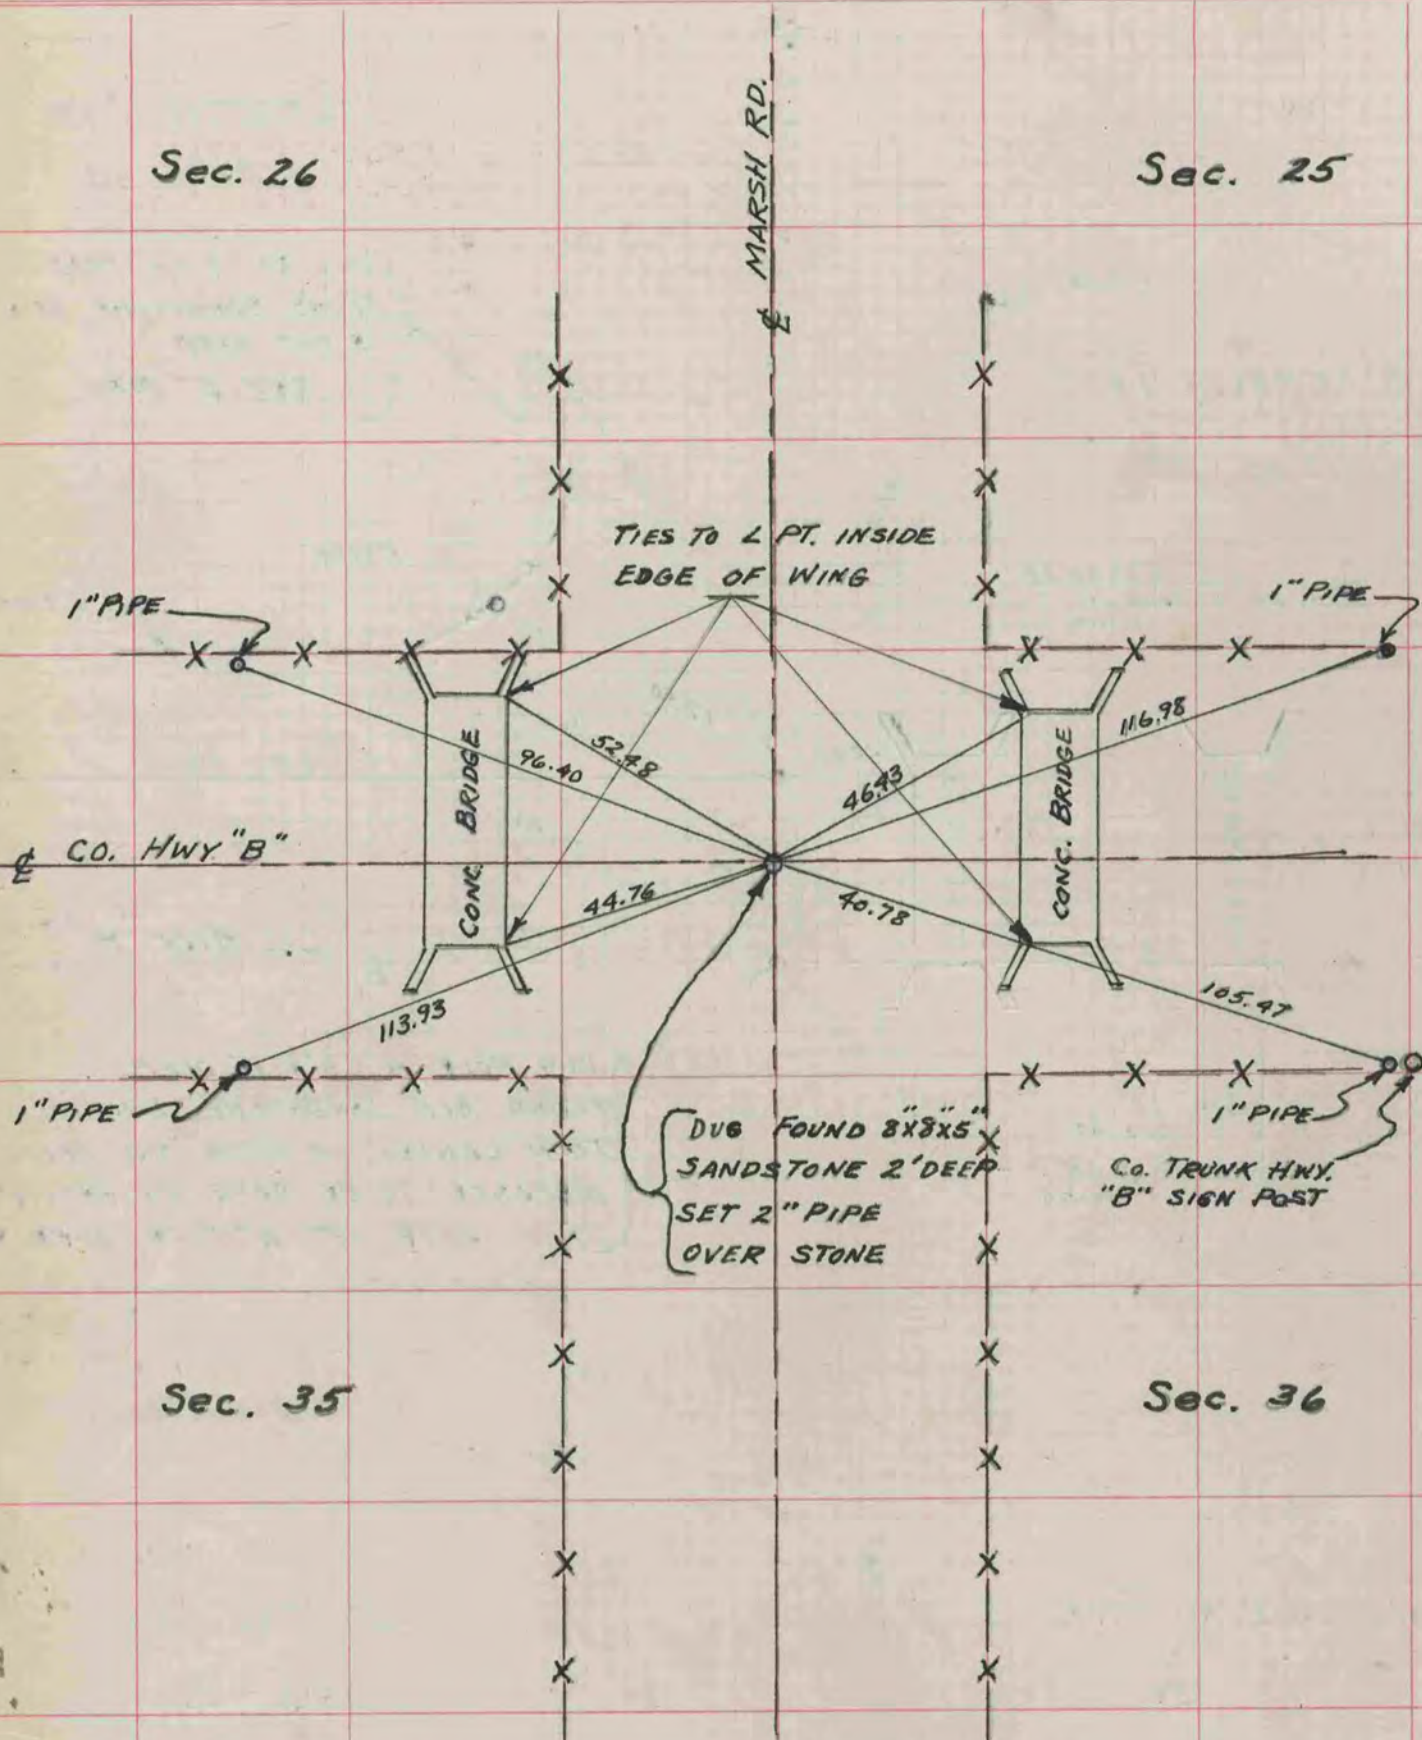

WORK DONE BY THE FOLLOWING:

- T.R. DULL
- S.R. CUSHMAN
- TOM WALSH