

MICROFILM PLAT AND RECORD

35
V-2

COUNTY BUILDING
CITY OF JANESVILLE


Of a Survey on Section 30 T 3 R 11 E. of the 4 P. M. in Centre Township

Rock County, Wisconsin, made July the 7 1870

I hereby certify that the following is a correct record of said survey as made by me.

(Signed) Edward Roger
R.H.B.

County Surveyor.

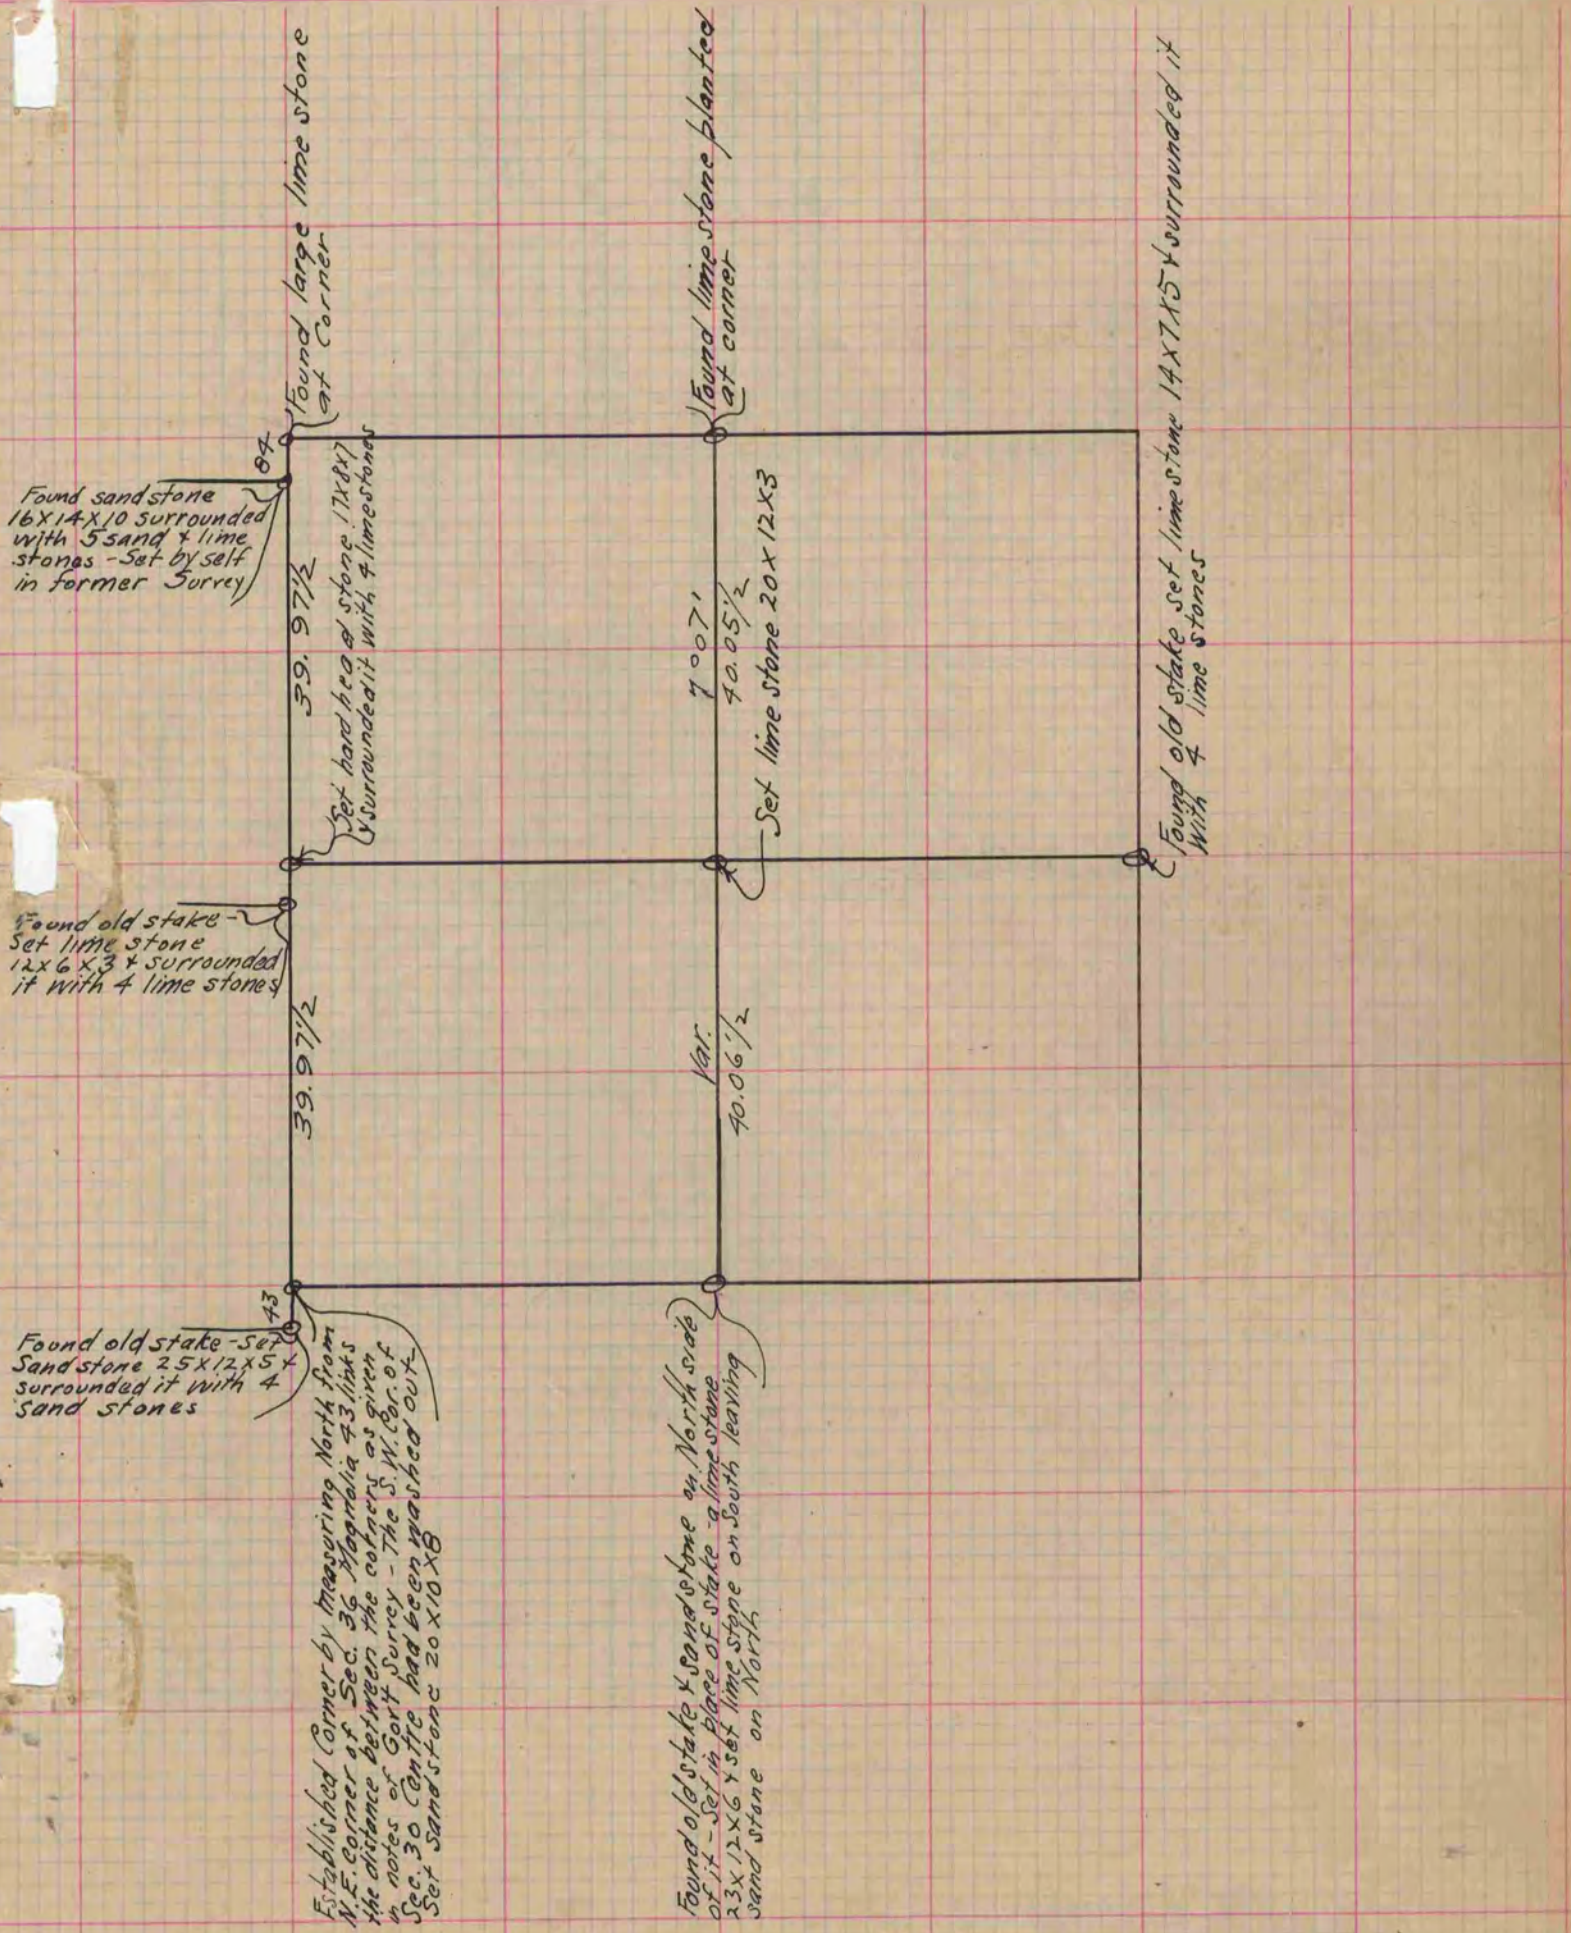

Copied from page 25 Vol. 2. Original County Surveyors Record