

# PLAT AND RECORD

COUNTY BUILDING  
CITY OF JANESVILLE

## MICROFILMED


Of a Survey on Section 15 T 4 R 12 E. of the 4 P. M. in Fulton Township

Rock County, Wisconsin, made January the 18, 19, 20, 21 1871

I hereby certify that the following is a correct record of said survey as made by me.

(Signed) Edward Ruger  
R.H.B. County Surveyor.

\* Copied from  
Beloit records  
12/10/75 B.O.

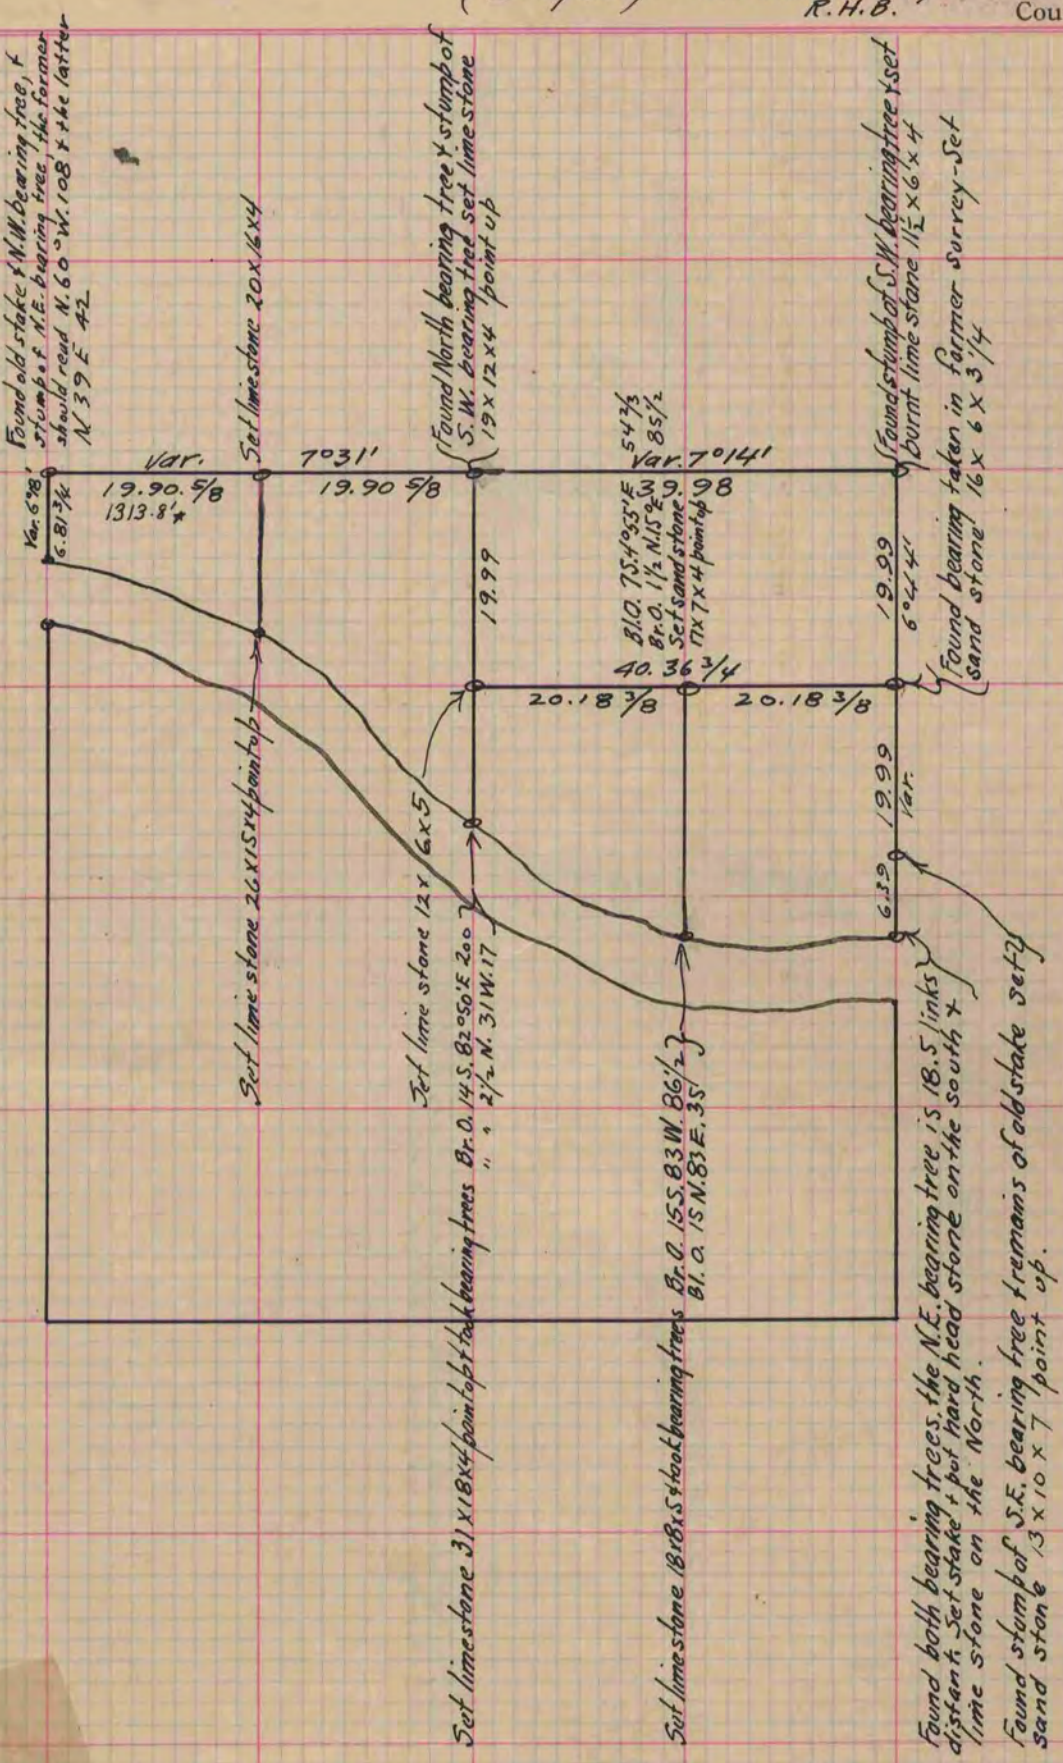

Copied from upper  $\frac{1}{2}$  of page 34 Vol. 2. Original County Surveyors Record