

PLAT AND RECORD

223

VOL. 6

Of a Survey on Section **35**, T **3** R **14** E. of the 4 P. M. in **JOHNSTOWN** Township
Rock County, Wisconsin, made **NOV** the **1981**

I hereby certify that the following is a correct report of said survey as made by me.

**COUNTY BUILDING
CITY OF JANESVILLE**

Donald A. Baines

DONALD A.
BAINES
S-1216
JANESVILLE
WI.

County Surveyor.



S 1/4 COR SEC 35

FOUND L.S. 18" UNDER PAVEMENT. SET ALUM MON




NE COR SEC 33

NE COR SEC 34

FOUND RECORD LIMESTONE.
SET CARSONITE POST


W 1/4 COR SEC 25

FOUND 1" IRON ROD SURROUNDED BY SMALL HH. FOUND
WOOD FIBERS DIRECTLY BELOW THE IRON ROD. REPLACED
WITH POLYSTYRENE MON & SET CARSONITE POST

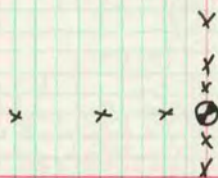

W 1/4 COR SEC 28

FOUND 2"X48" GAS PIPE SET BY KERCH IN 1901@ FENCE INT.
REPLACED WITH POLYSTYRENE MON & SET CARSONITE POST.

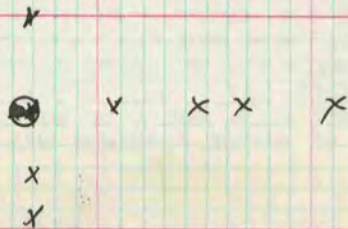

MICROFILMED