

V-2 **MICROFILMED** PLAT AND RECORD

Of a Survey on Section 4 T 2 R 14 E. of the 4 P. M. in Bradford Township  
Rock County, Wisconsin, made November the 15<sup>th</sup> 1883

I hereby certify that the following is a correct record of said survey as made by me.

**COUNTY BUILDING  
CITY OF JANESVILLE**


(Signed) B. K. Lee

Dep. County Surveyor.

Locust tree formerly on cor. is now gone  
but found old stake a little N. of post at S. end  
of fence which I take for Cor.

40.92 1/2 Var. 5.925'  
20.46 1/4  
Set H.H. 12x8x8

H.H. set by Ruger 1878 could not be  
found - assumed an old fence post near  
40.92 1/2 to be on Sec. line the dist. 40.92 1/2  
being determined by projecting the E. 1/4  
1/2 Sec. line through the center of the  
Sec. from E. 1/4 Cor.

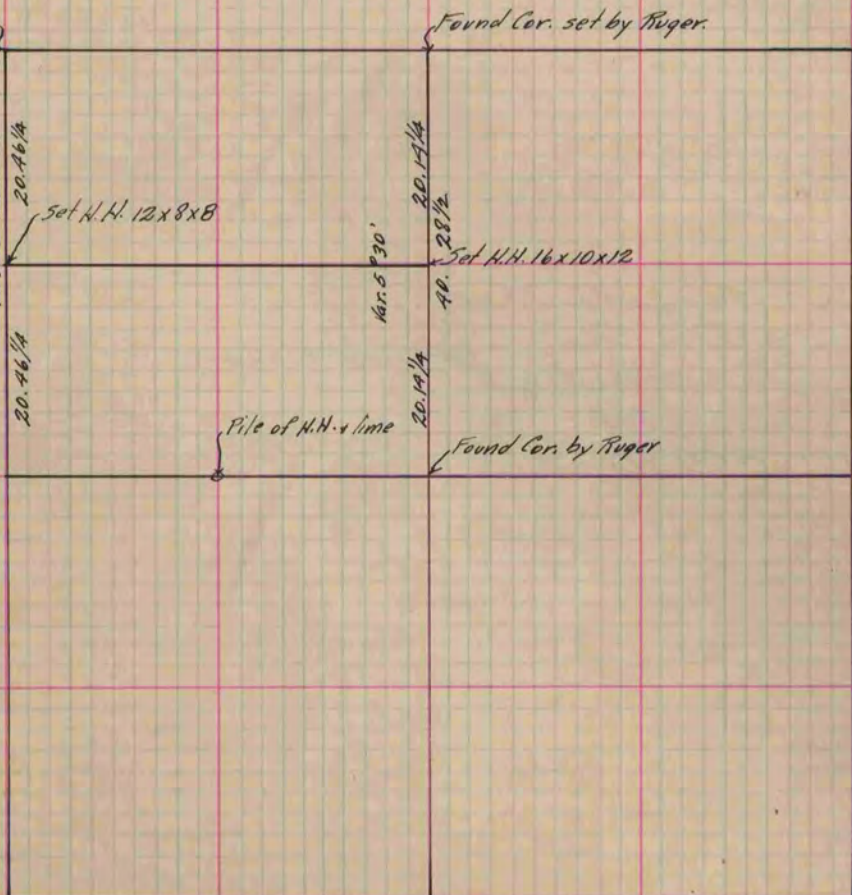

Copied From P. 291 Vol. 2 County Surveyor's Record.