

**MICROFILMED** PLAT AND RECORD

Of a Survey on Section 15 T 4 R 13 E. of the 4 P. M. in Milton Township


Rock County, Wisconsin, made May the 22<sup>nd</sup> 1879

I hereby certify that the following is a correct record of said survey as made by me.

COUNTY BUILDING  
CITY OF JANESVILLE

(Signed) Edward Ruger

County Surveyor.

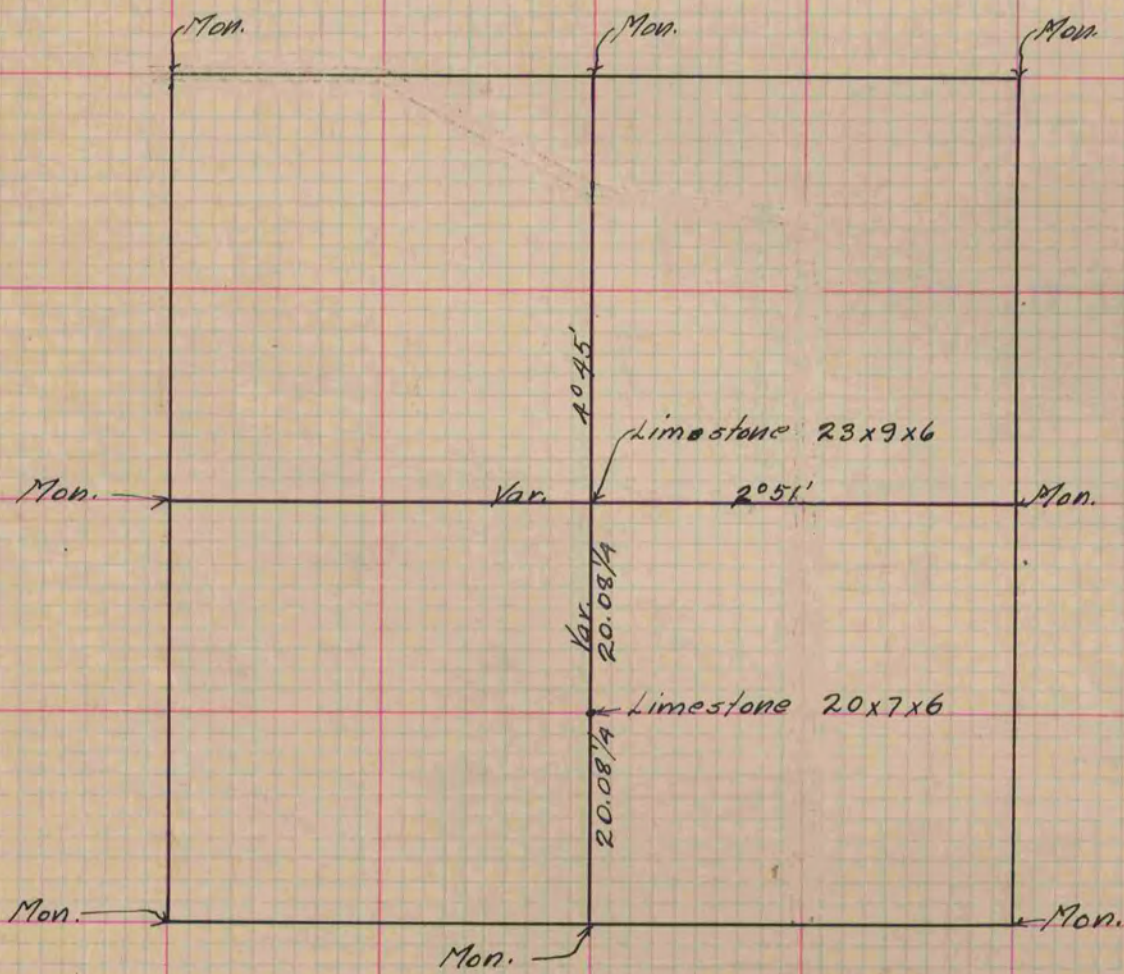

Copied from Page 221 Vol. 2 Original County Surveyor's Record.