

PLAT AND RECORD

Of a Survey on Section 16 T. 4 N., R. 10 E. of the 4 P. M. in Township
Rock County, Wisconsin, made May the

I hereby certify that the following is a correct record of said survey made by O. Schroeder


COUNTY BUILDING
CITY OF JANESVILLE

COUNTY BUILDING
CITY OF JANESVILLE



S. 1/4 CORNER - SECTION 16

MICROFILMED

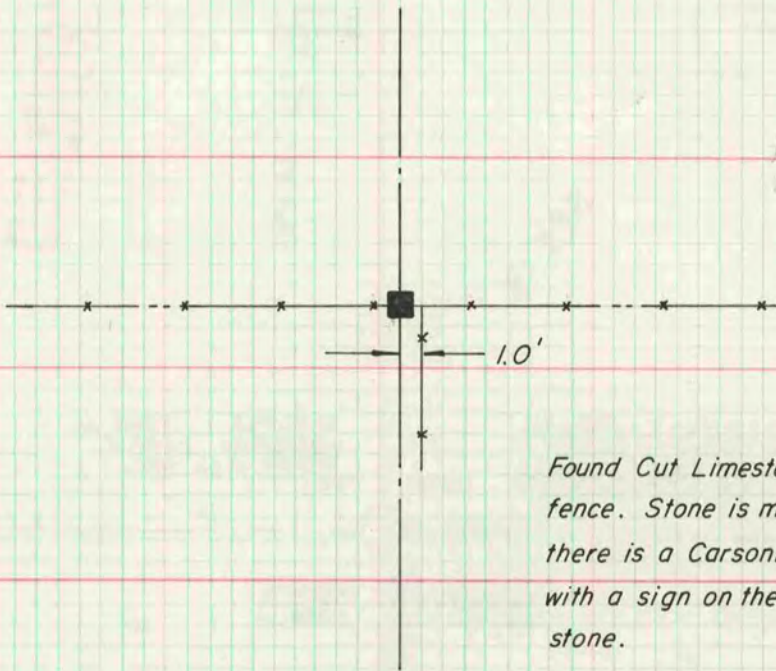

Found Cut Limestone 1.0' West of a fence. Stone is marked S. 1/4 and there is a Carsonite Boundary Marker with a sign on the south side of the stone.