

MICROFILMED

PLAT AND RECORD

61
V-2


COUNTY BUILDING
CITY OF JANESVILLE

Of a Survey on Section 2 T 2 R 12 E. of the 4 P. M. in Rock Township

Rock County, Wisconsin, made May the 8th 1871

I hereby certify that the following is a correct record of said survey as made by me.

(Signed) Edward Ruger
R.H.B. County Surveyor.

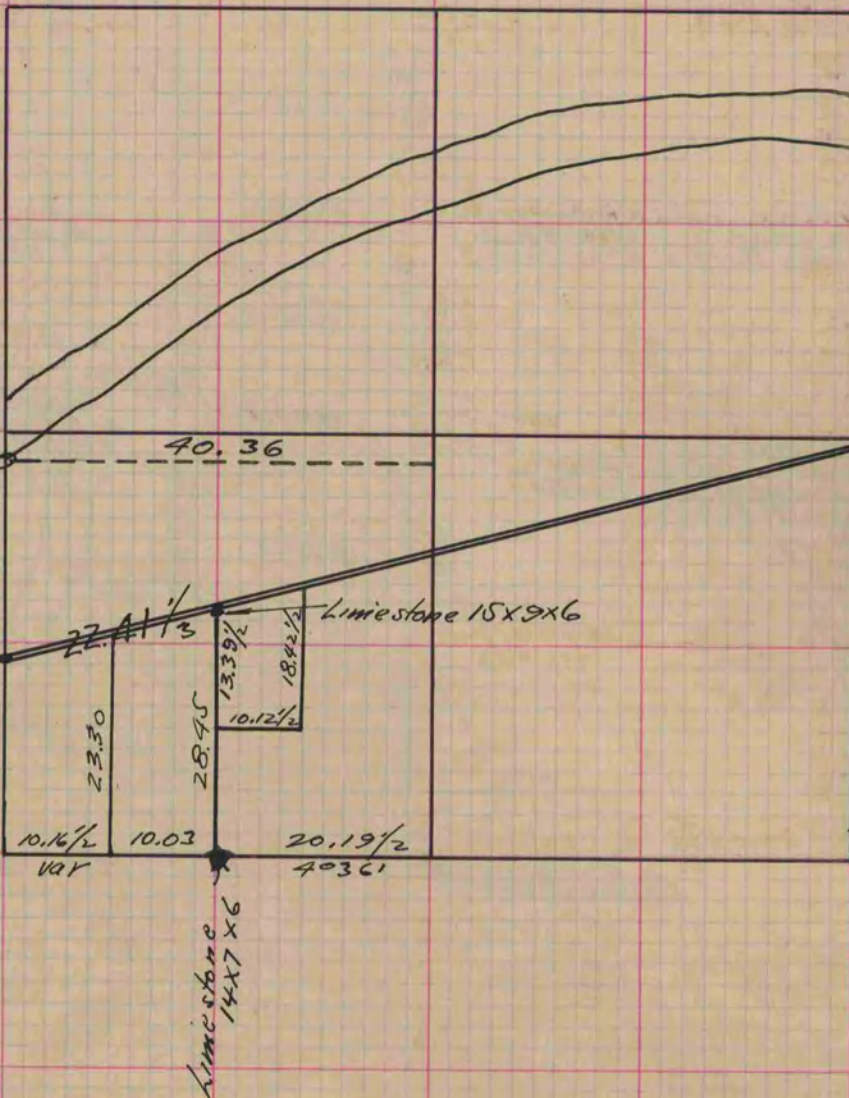

Copied from Page 38 Vol. 2. Original County Surveyors Record