

# PLAT AND RECORD

261  
VOL. 6

Of a Survey on Section 7, 18 T 4 R 12 E. of the 4 P. M. in FULTON Township  
Rock County, Wisconsin, made MAY the 19 82

I hereby certify that the following is a correct record of said survey as made by me.


COUNTY BUILDING  
CITY OF JANESVILLE

*Donald A. Barnes*



County Surveyor.

THE G. D. BARNARD COMPANY, ST. LOUIS

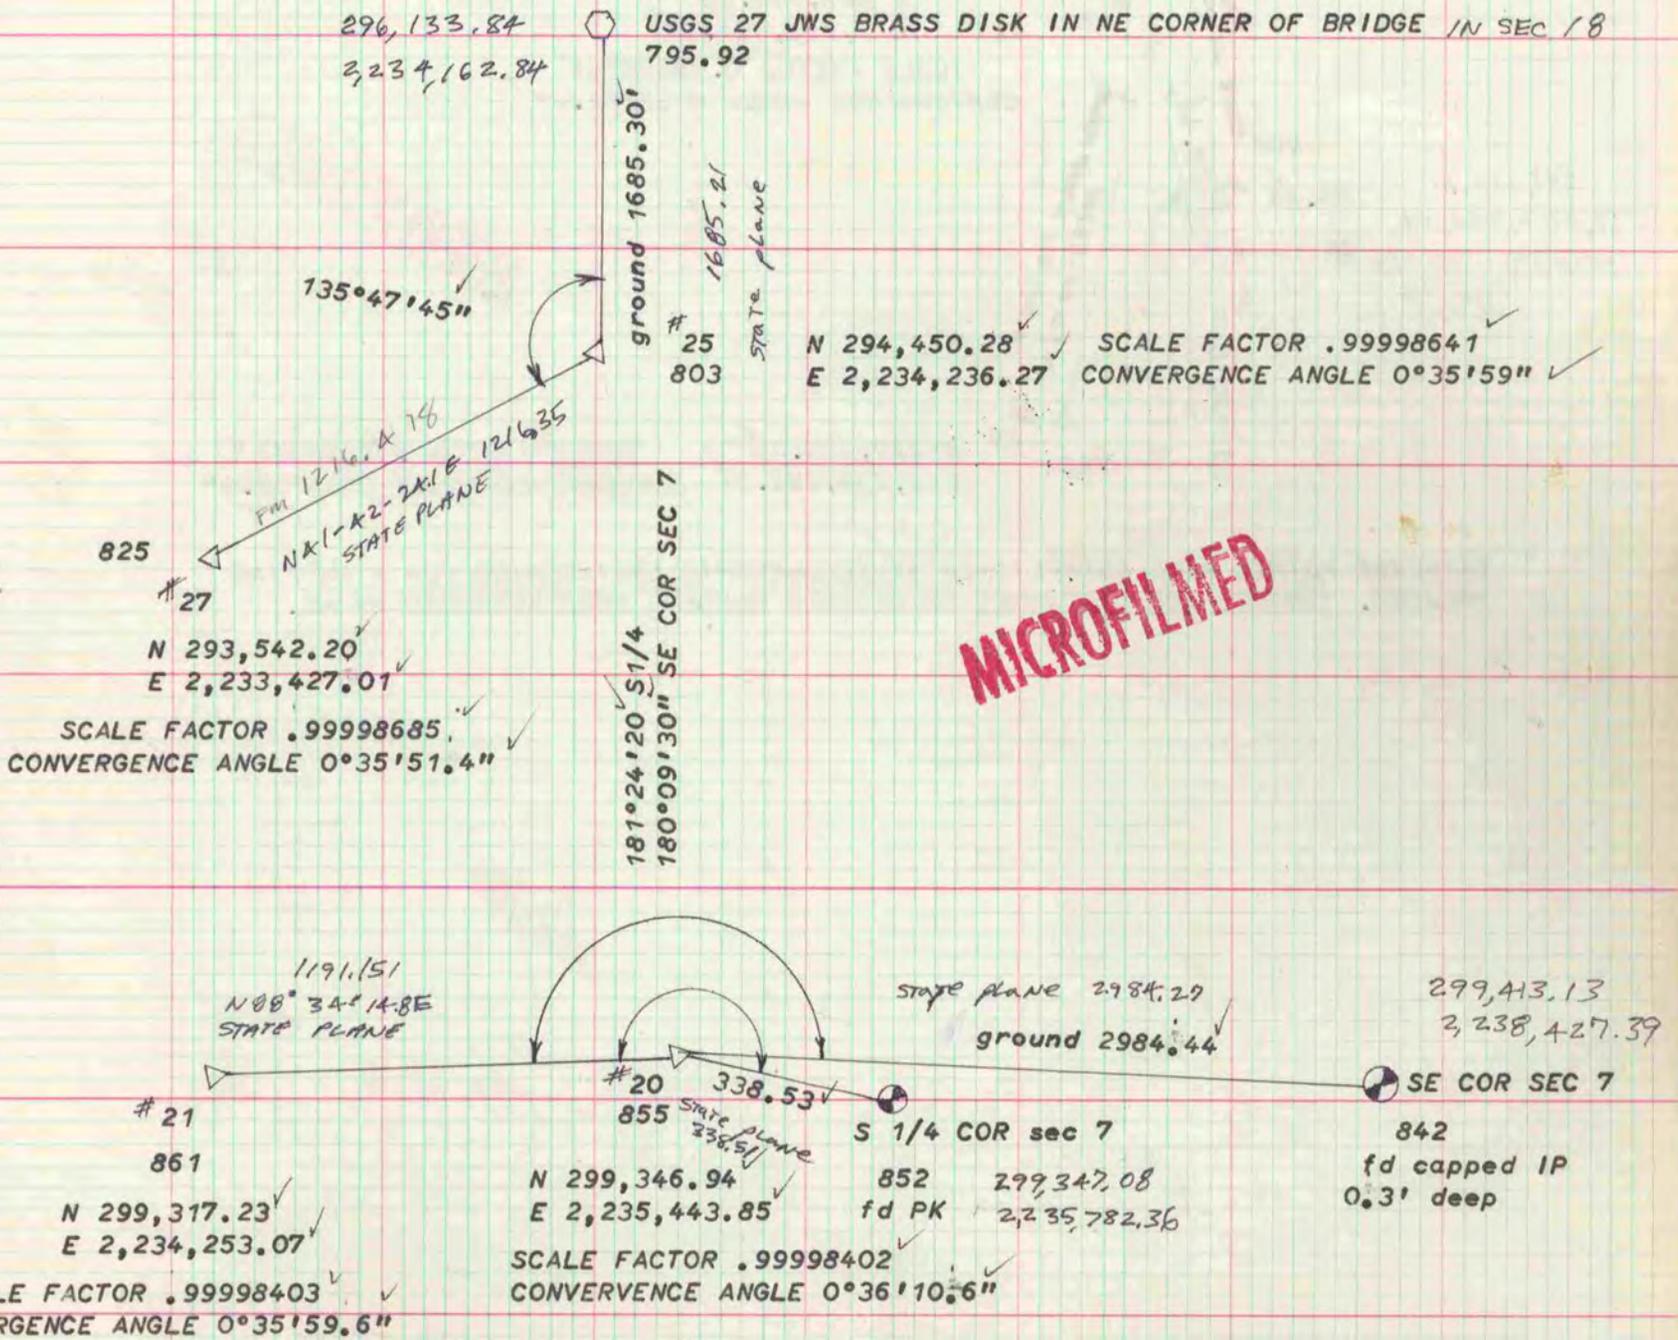

**MICROFILMED**

TRAVERSE POINTS WERE ESTABLISHED BY AERO-METRIC ENGINEERING FOR A MAPPING PROJECT. ANGLES AND DISTANCES TO SECTION CORNERS WERE MEASURED BY ME.