

PLAT AND RECORD

201
VOL. 6

Of a Survey on Section **16, 18, 20** T **4** R **12** E. of the 4 P. M. in **FULTON** Township
Rock County, Wisconsin, made **SEPT.** the **22**

I hereby certify that the following is a correct record of said survey as made by me.

COUNTY BUILDING
CITY OF JANESVILLE



NW COR SEC 16


FD ALUM. MON.

E 1/4 COR SEC 18

FD ALUM. MON.


W 1/4 COR SEC 18

FD 1" I.P. REPLACED WITH ALUM. MON.

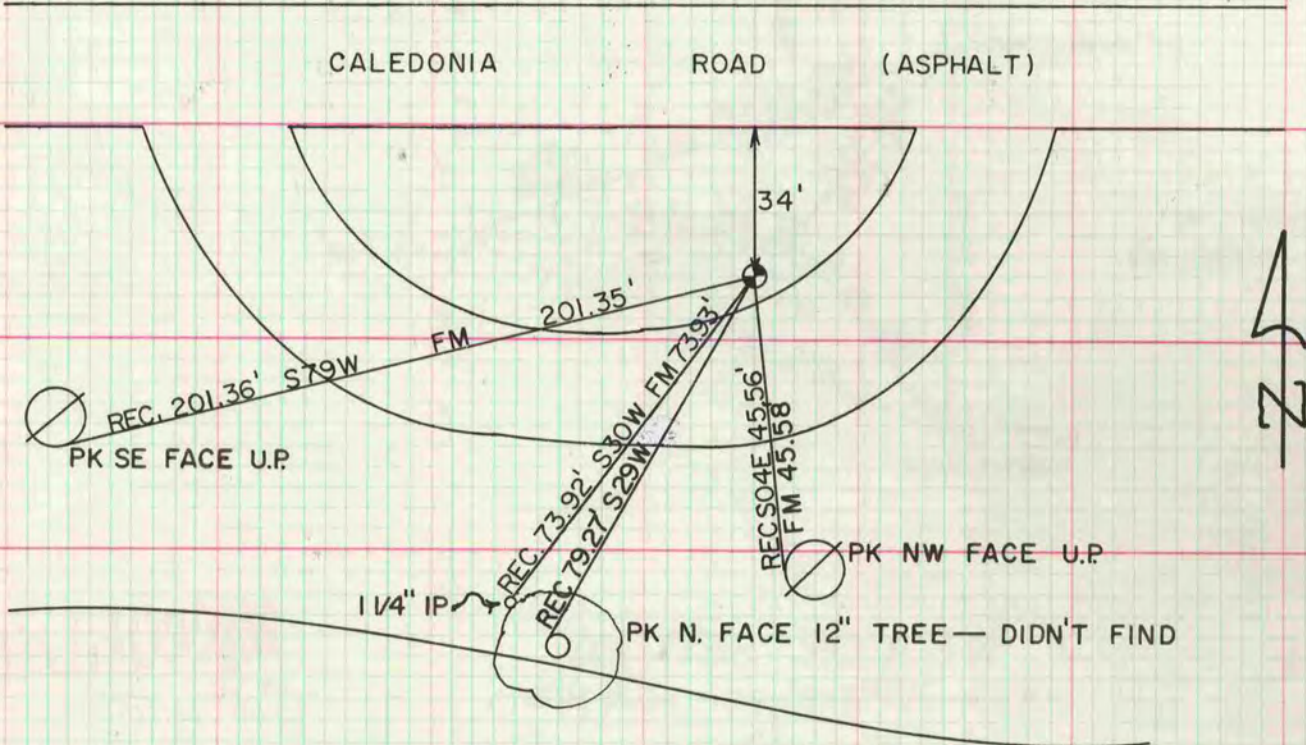

S 1/4 COR SEC 20

FD PK NAIL 1.2' DEEP FD L.S. O BY 4 H.H.'s SET ALUM MON

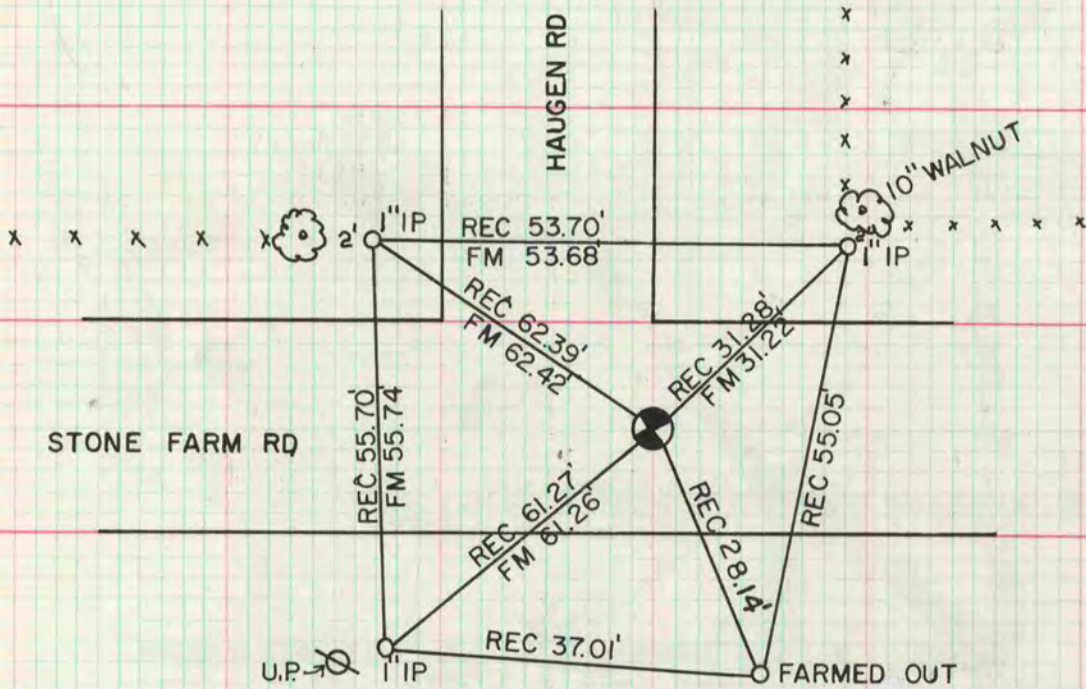

MICROFILMED