

PLAT AND RECORD

VOL. 6

Of a Survey on Section **27** T **4** R **10** E. of the 4th Township

Rock County, Wisconsin, made **APRIL** 19 **81**


I hereby certify that the following is a correct record of said survey as made by me.

**COUNTY BUILDING
CITY OF JANESVILLE**




County Surveyor.

S 1/4 COR SEC 27
DATA SUPPLIED BY WALWORTH COUNTY SURVEYOR

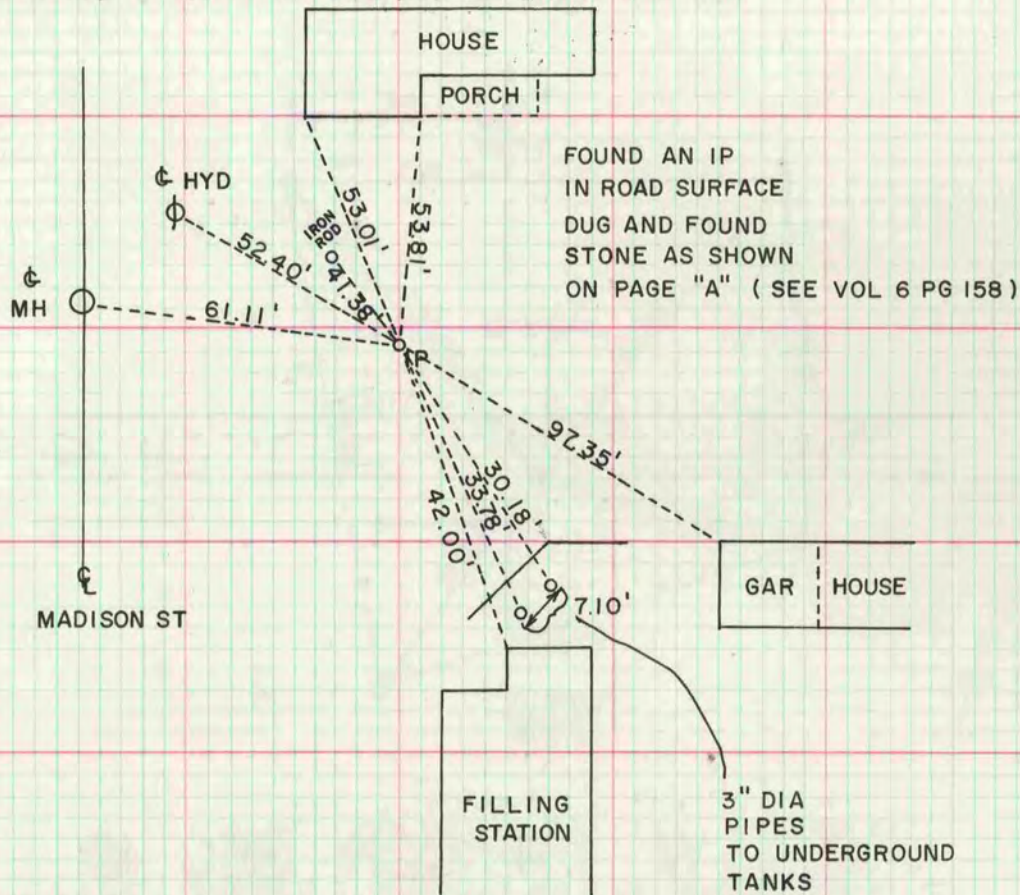

SW COR SEC 27
DATA SUPPLIED BY WALWORTH COUNTY SURVEYOR

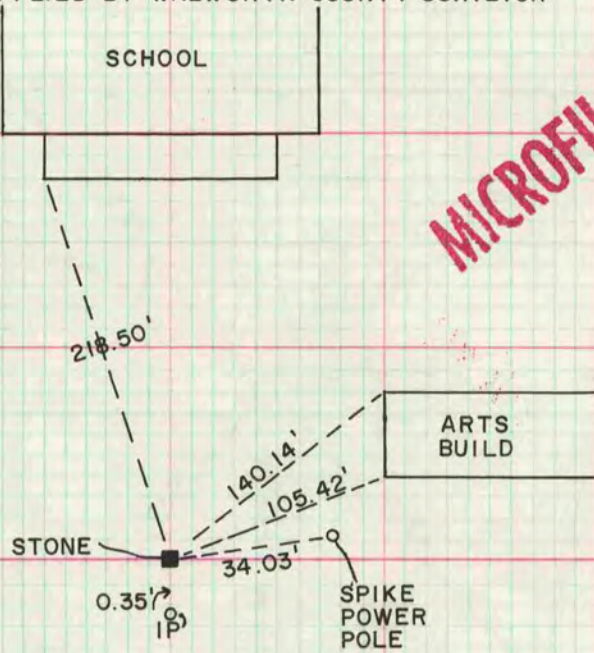

MICROFILMED