

PLAT AND RECORD

209


BRADFORD VOL. 6

Of a Survey on Section 32 2 14 T 3 R 14 E. of the 4 P. M. in JOHNSTOWN Township
Rock County, Wisconsin, made *Oct* the _____

I hereby certify that the following is a correct record of said *DAMES* as made by me.


COUNTY BUILDING
CITY OF JANESVILLE

Paul Barnes

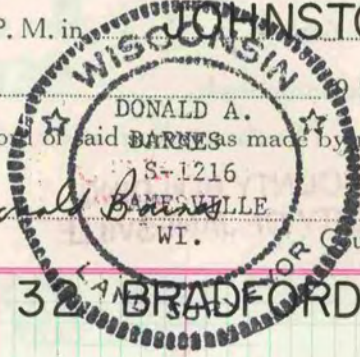


County Surveyor.

CENTER COR SEC 32 BRADFORD

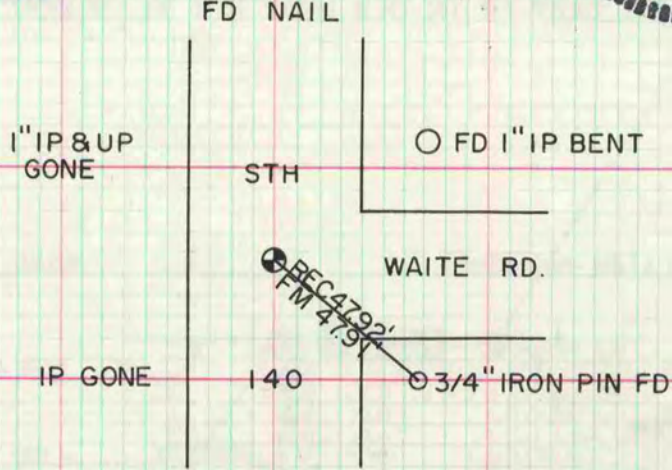

NW COR SEC 13 JOHNSTOWN
FD BOTTOM HALF OF ALUM MON RESET
ALUM MON

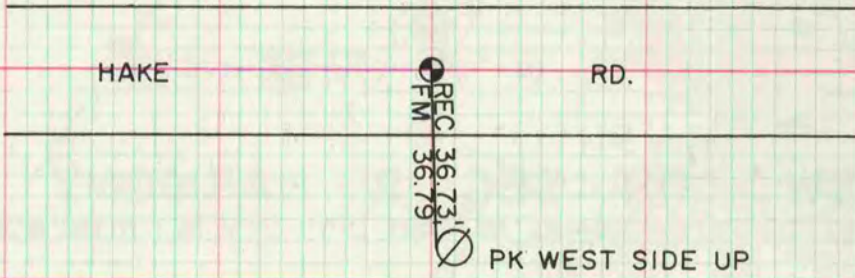

MICROFILMED