



Of a Survey on Section 25, 26, 35, 36 T. 2 R. 14 E. of the 4 P. M. in BRADFORD Township
Rock County, Wisconsin, made NOV the 1981

I hereby certify that the following is a correct record of a survey as made by me.

COUNTY BUILDING
CITY OF JANESVILLE

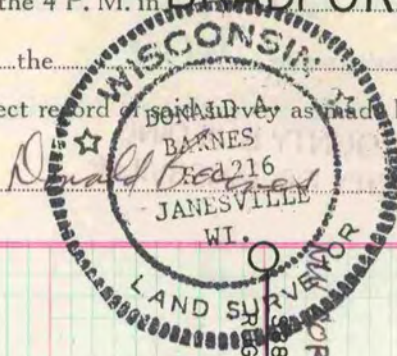

County Surveyor.

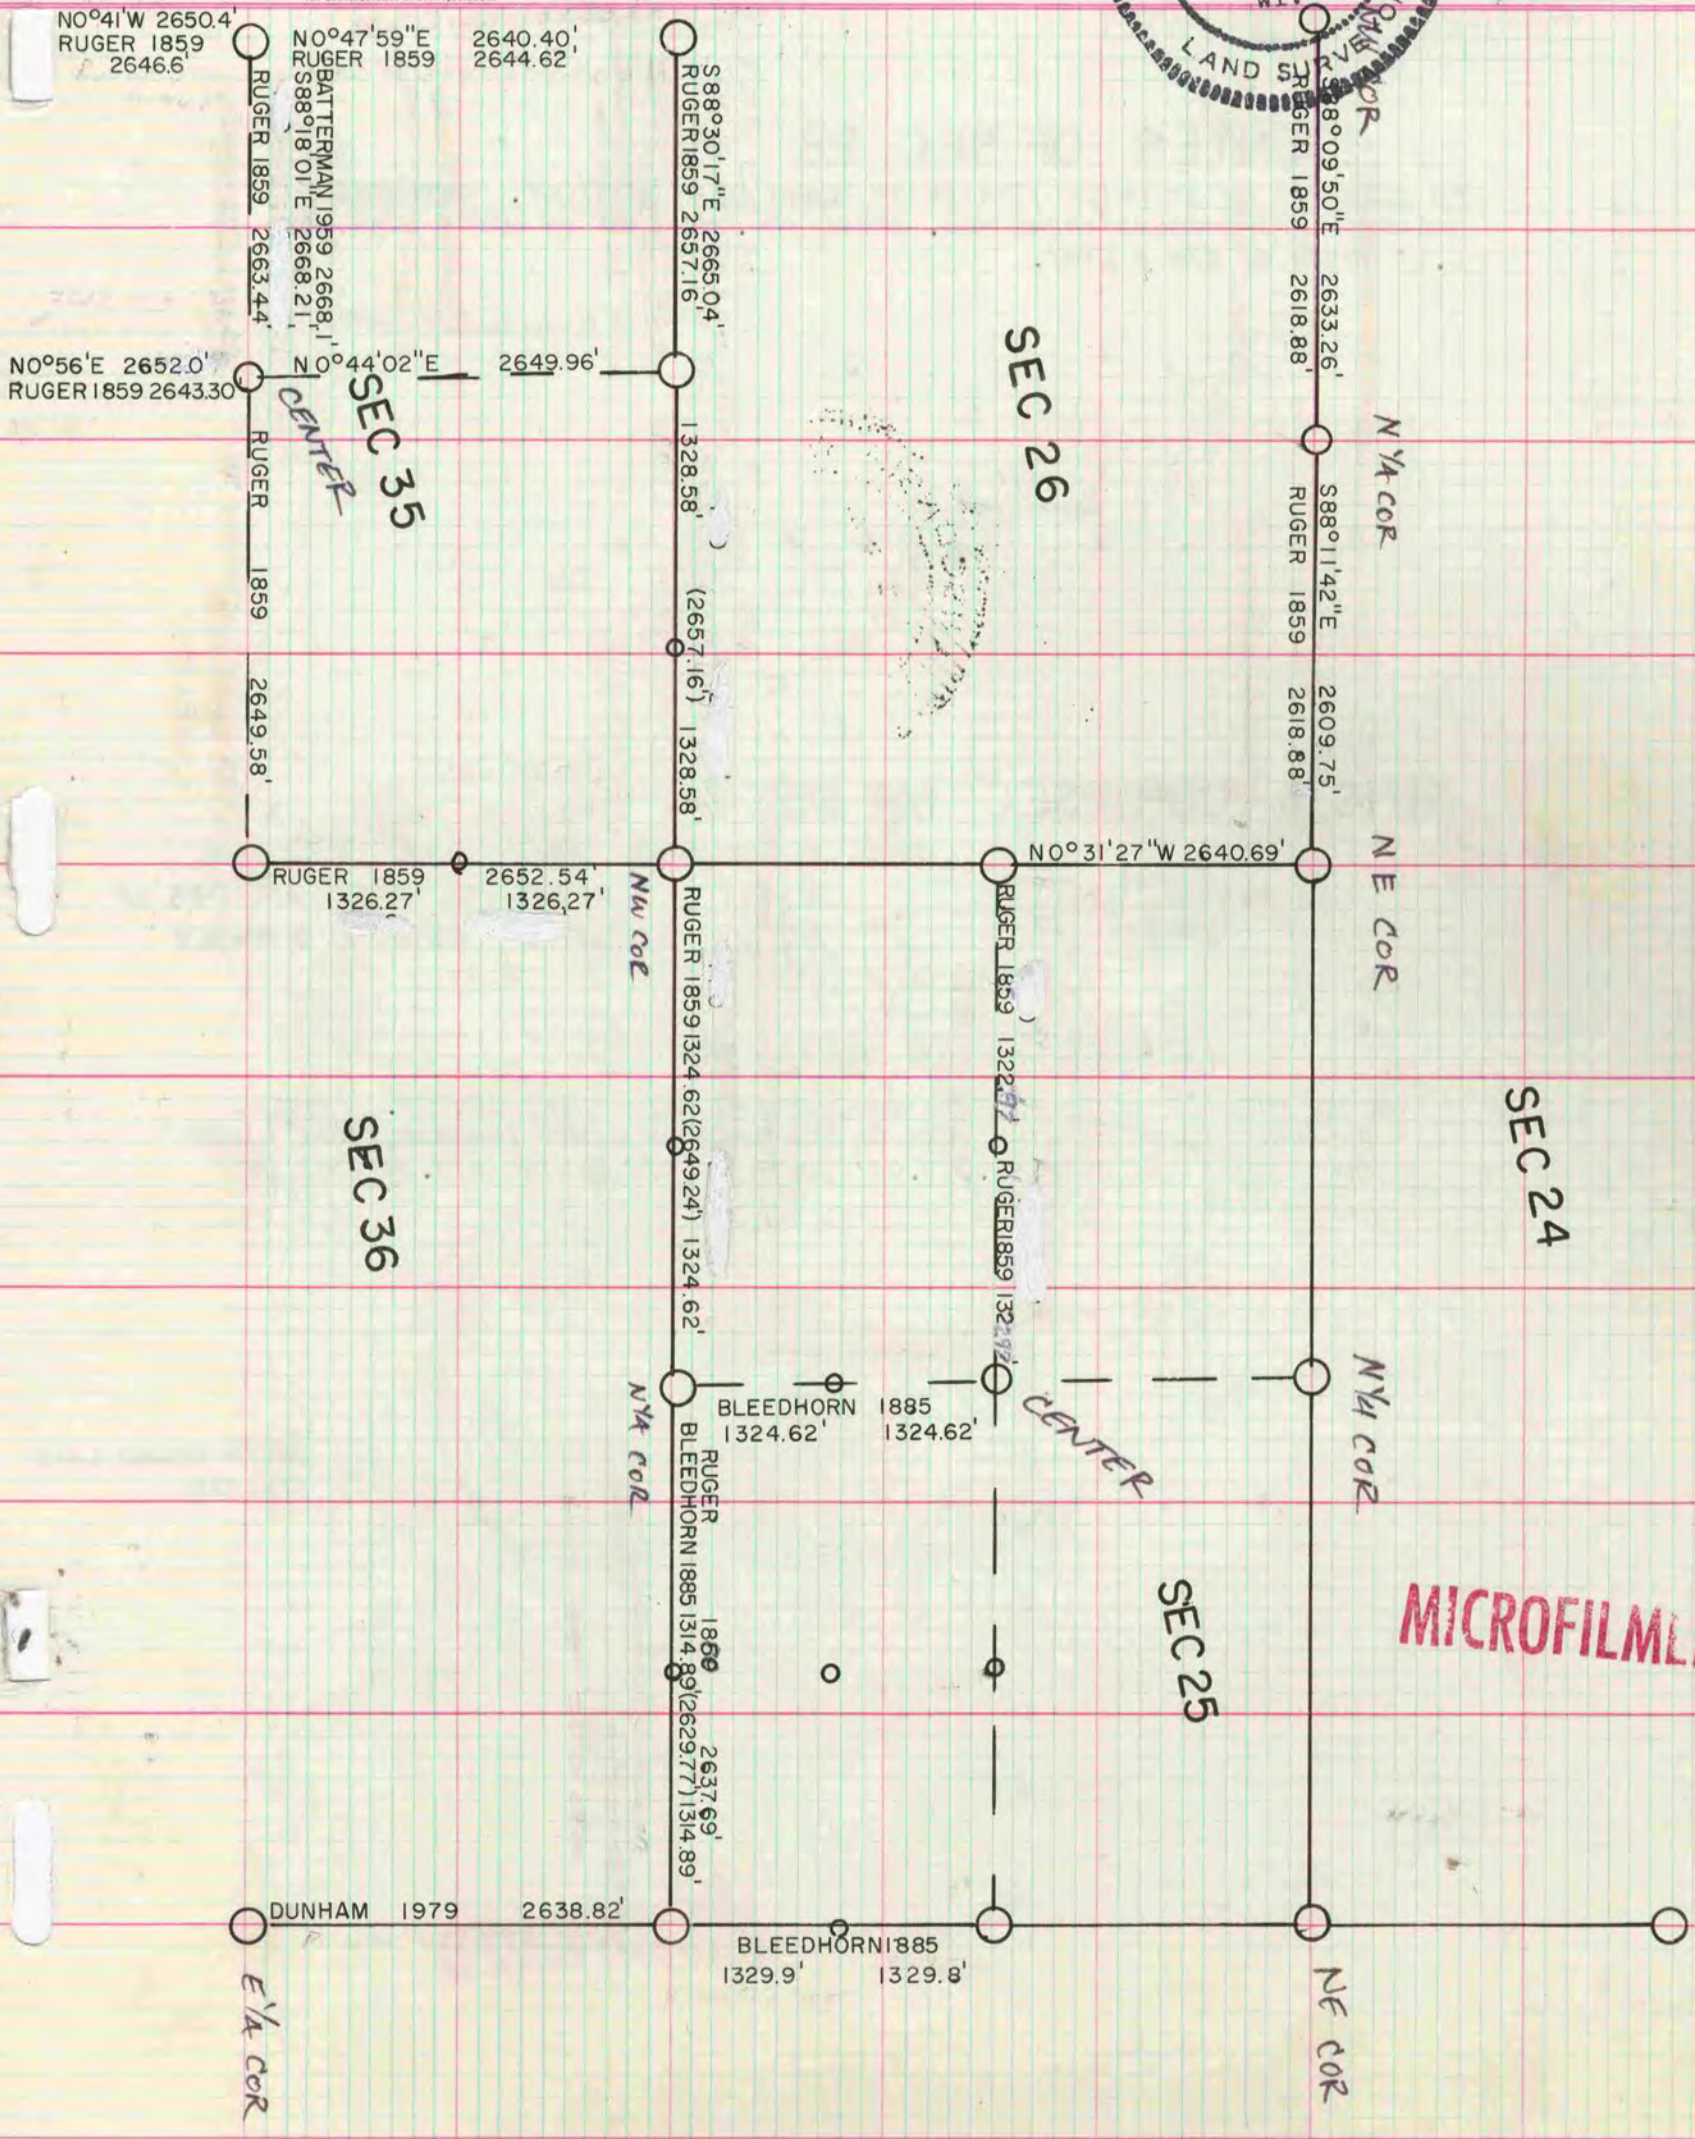

MICROFILMLD