

VOL. 6 PLAT AND RECORD

Of a Survey on Section 18, 19 T 1 R 14 E. of the 4 P. M. CLINTON Township
Rock County, Wisconsin, made NOV 3 1980

I hereby certify that the following is a correct record of said survey as made by me.


COUNTY BUILDING
CITY OF JANESVILLE




County Surveyor.

S 1/4 COR SEC 18

FOUND POST WITH POINTED END. THIS IS IN HARMONY WITH
OCCUPATION & RECORD DISTANCES, REPLACED WITH ALUM
MON

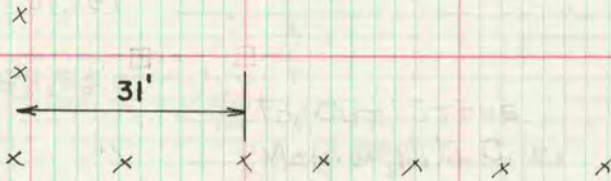


FARM LANE

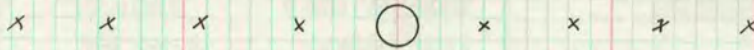


E 1/4 COR SEC 18

DUG & FOUND NOTHING. SET ALUM MON ON LINE WITH
NE & SE CORNERS OF SEC 18 AT SINGLE PROPORTIONATE
DISTANCE.

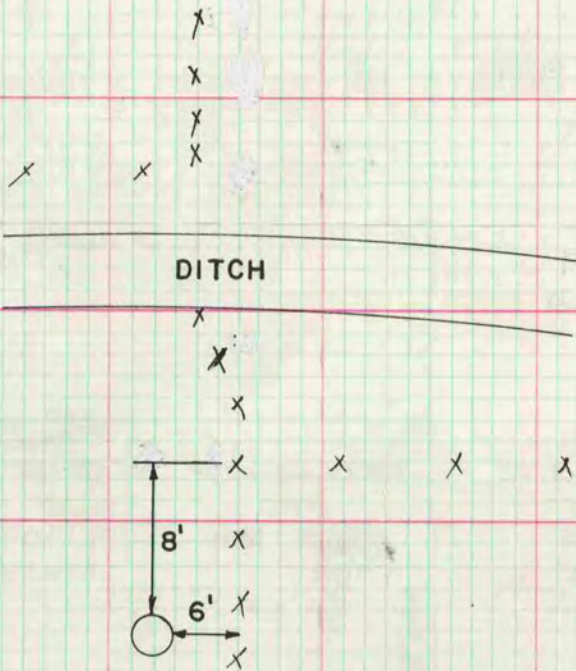

E 1/4 COR SEC 19

DUG & FOUND NOTHING. SET ALUM MON ON LINE WITH
SE & NE CORNERS OF SEC 19 AT SINGLE PROPORTIONATE
DISTANCE

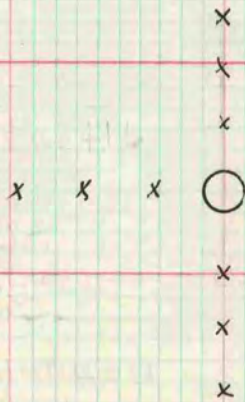

MICROFILMED