

# PLAT AND RECORD

Of a Survey on Section 29 T 4 R 11 E. of the 4 P. M. in Porter Township


Rock County, Wisconsin, made June the 6-7-8 1871

I hereby certify that the following is a correct record of said survey as made by me.

COUNTY BUILDING  
CITY OF JANESVILLE

(Signed) Edward Ruger  
R.H.B.

County Surveyor.

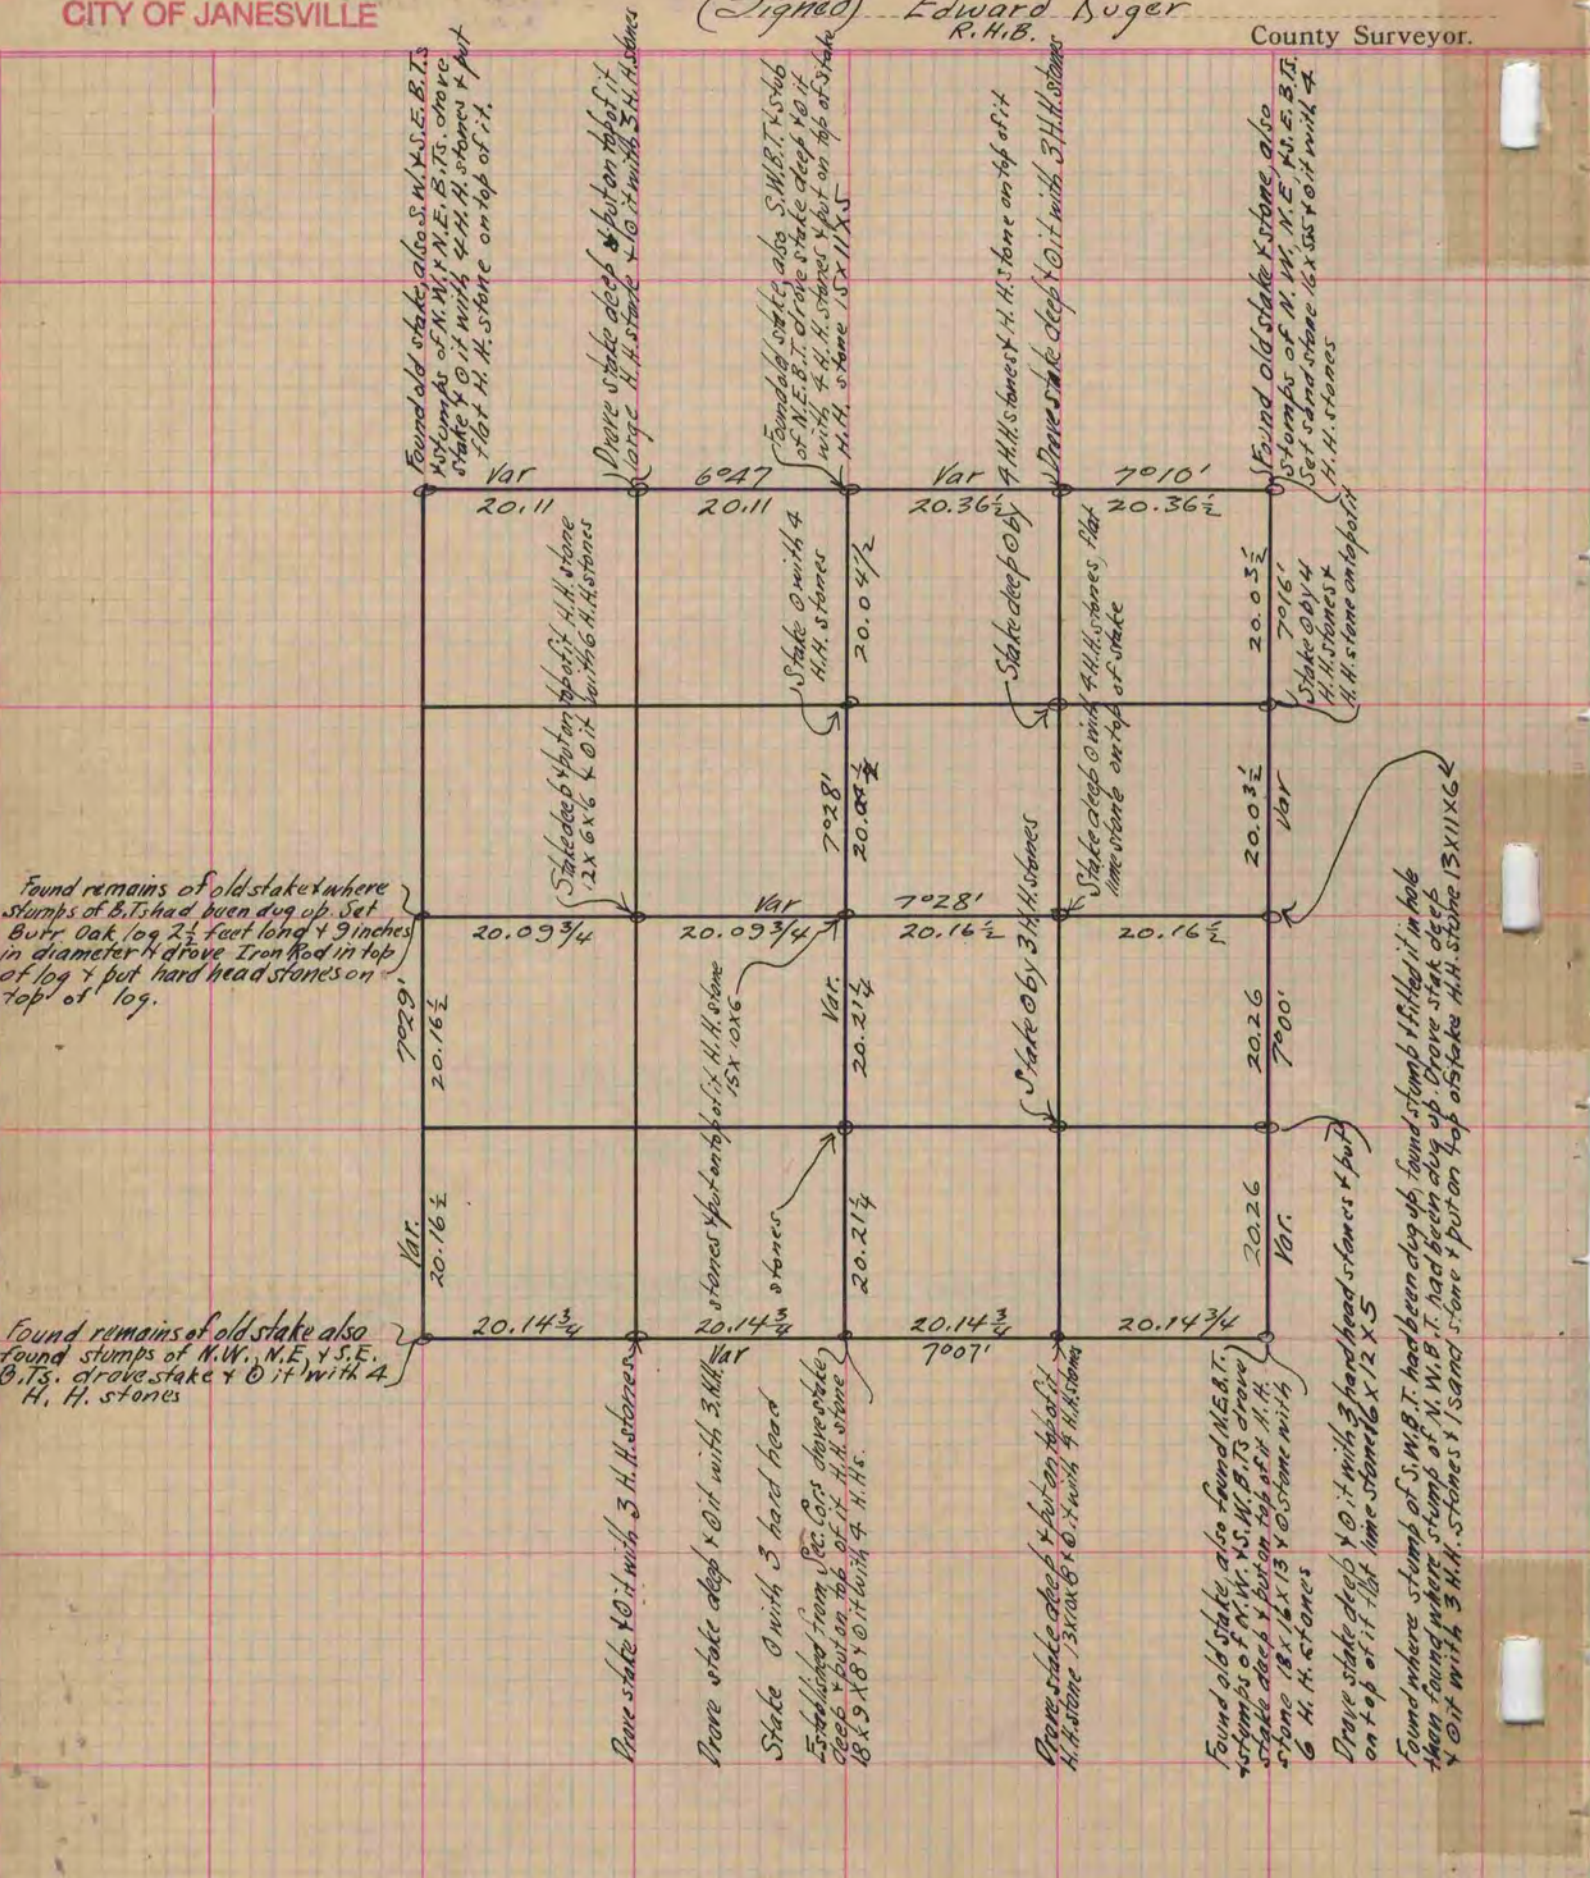

Copied from lower 1/2 of Page 41 Vol. 2 Original County Surveyors Record