

# PLAT AND RECORD

COUNTY BUILDING  
CITY OF JANESVILLE


COUNTY BUILDING  
CITY OF JANESVILLE

Of a Survey on Section 16 T 1 R 10 E. of the 4 P. M. in Avon Township

Rock County, Wisconsin, made JUNE the 1970

I hereby certify that the following is a correct record of said survey as made by me.

*Michael R. Batteman*  
County Surveyor.

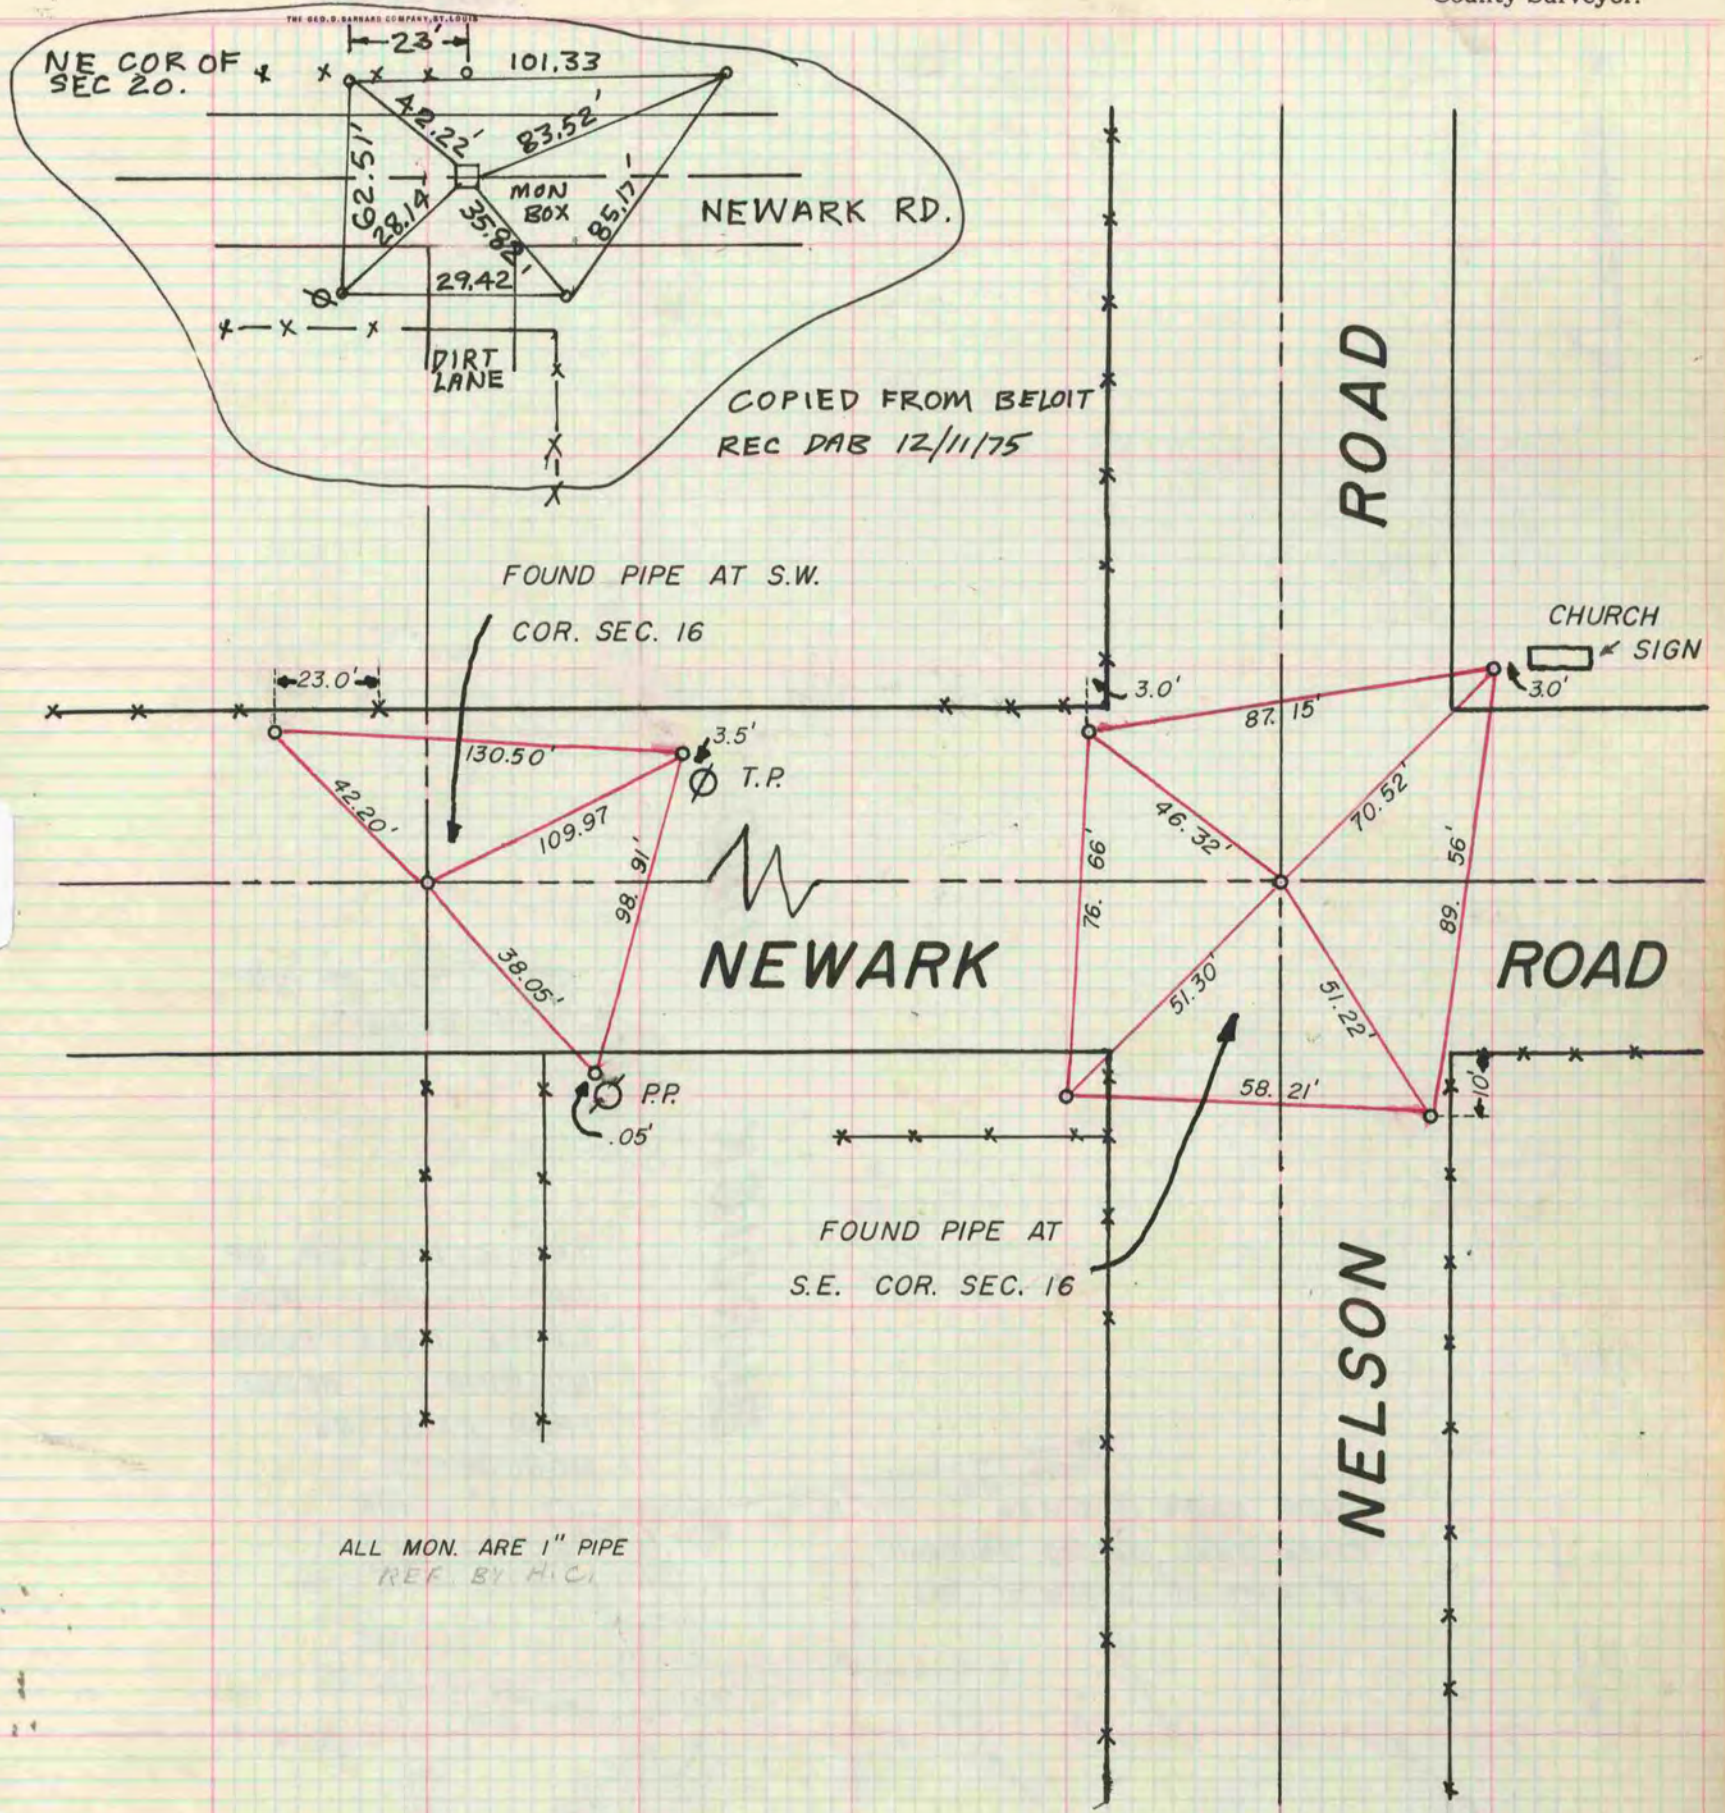

ALL BEARINGS ARE ASTRONOMIC NORTH BEARINGS