
LAND SURVEY MONUMENT RECORD U.S. PUBLIC

For Public Land Survey Corners in the

T. 4 N., R. 14 E.



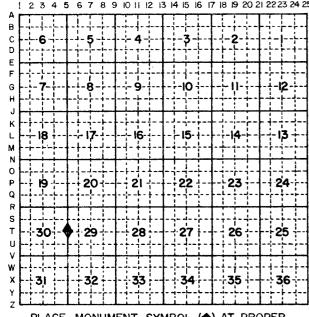

PLACE MONUMENT SYMBOL (*) AT PROPER LOCATION ON ABOVE INDEX


> IF AVAILABLE STATE PLANE COORDINATES

Eleve (Z) 905 North (Y) 286, 010,14


East (X) 301,357.77 Zone 500TH


Hor. Datum _____ Vert. Datum

For Miscellaneous Corners within Sec. 30 ,T. 4 N., R. 14 E.

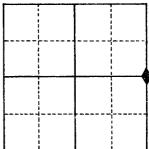


- Above code numbers are positioned 1. Meander, Claim, or Fractional corners of the section.
- Township corner code numbers shall be applied to the corners of above typical section.

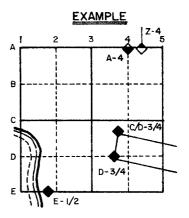

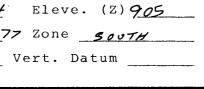

CORNER MONUMENT

O WITNESS MONUMENT

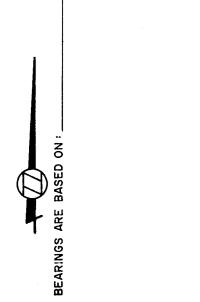

FIELD BOOK page 64 LIMA VOL 2 page 80 REFERENCED

> SHOW A PLAN VIEW DRAWING DEPICTING THE CORNER MONUMENT AND SURROUNDING PHYSICAL FEATURES, INCLUDING THE EXCAVATION AREA AND DEPTH. THE CORNER MONUMENT SHALL HAVE THE FOLLOWING CHARACTERISTICS: 1) HAVE AT LEAST TWO PREDETERMINED BREAK-OFF POINTS. 2) IF BROKEN, LEAVE A PERMANENTLY MAGNETIZED REMNANT AT THE ORIGINAL POINT. 3) MUST BE EXTENDABLE. 4) THE CAP IS INSCRIBED : ROCK COUNTY SURVEY MONUMENT - PENALTY FOR DISTURBING MARKER. 5) OR AN EXISTING CUT LIMESTONE. AN IRON PIPE 1/2" x 4'0" (MINIMUM) WITH AT LEAST 4 DURABLE WITNESS MONUMENTS MAY BE USED IN AREAS WHERE GROUND WATER IS WITHIN 1.0' OF THE SURFACE. IF THE CORNER IS OCCUPIED BY AN IMPROVEMENT (MANHOLE, BURIED CABLE, ETC.), ANY DURABLE, DISTINCT MONUMENT MAY BE USED AND REFERENCED WITH AT LEAST 4 DURABLE WITNESS MONUMENTS.

> > CORNER CODE: 7

Four	D MO AN GIVENT OF RECORD
	THE PURE STILL OF FELLEN
Descri	be any material discrepancy between the location of the
corner	as restored or re-established and the location of that as previously restored or re-established.
Tourish Profession Profession Building	
	ne corner restored through acceptance of an obliterated acce location or a found perpetuated location.
A C	CEPTED FOUND PERPETUATED LOCATION
method distar	ne corner re-established through lost corner proportionate ls? If so, show the method, including directions and ces to other public land survey corners used as evidence ed for proportioning in determination of the corner location
method distar	s? If so, show the method, including directions and coes to other public land survey corners used as evidence
method distar	s? If so, show the method, including directions and coes to other public land survey corners used as evidence
method distar	s? If so, show the method, including directions and ces to other public land survey corners used as evidence
method distar	s? If so, show the method, including directions and coes to other public land survey corners used as evidence
method distar	s? If so, show the method, including directions and coes to other public land survey corners used as evidence
method distar	s? If so, show the method, including directions and ces to other public land survey corners used as evidence
I, as ide	hereby certify that the corner pointified by the corner code index were, in a field survey of a field survey of the corner pointified by the corner code index were, in a field survey of the code index were.
I, as ide Tecoveregula instru	hereby certify that the corner pointified by the corner code index were, in a field survey of a field survey of the corner pointified by the corner code index were, in a field survey of the code index were.
I, as ide Tecoveregula instru	Low Bound , hereby certify that the corner pointified by the corner code index were, in a field survey or nestablished, re-established, monumented, re-monured or restored as expressed below and in conformance with tions and rules as required in the current manual of surve actions of the United States Department of Interior, Bureau
I, as ide Tecoveregula instru	As it so, show the method, including directions and lees to other public land survey corners used as evidence and for proportioning in determination of the corner location intified by the corner code index were, in a field survey on the corner code index were, in a field survey of
I, as ide Tecoveregula instru	North Banes , hereby certify that the corner point if ied by the corner code index were, in a field survey of restablished, re-established, monumented, re-monumented or restored as expressed below and in conformance with tions and rules as required in the current manual of survex of the United States Department of Interior, Bureau di Management. COUNTY SURVEYOR FILING DATA
I, as ide Tecoveregula instru	services to other public land survey corners used as evidence and for proportioning in determination of the corner location of the corner continuity of the corner code index were, in a field survey on the corner code index were, in a field survey on the corner code index were, in a field survey on the corner code index were, in a field survey on the corner code index were, in a field survey or the corner code index were, in a field
I, as ide June recoveregula instru	Responsible to other public land survey corners used as evidence and for proportioning in determination of the corner location of location of the location of loca