
SURVEY MONUMENT RECORD U.S. PUBLIC LAND


For Public Land Survey Corners in the LIMA T. 4 N., R. 14 E.

CORNER CODE INDEX

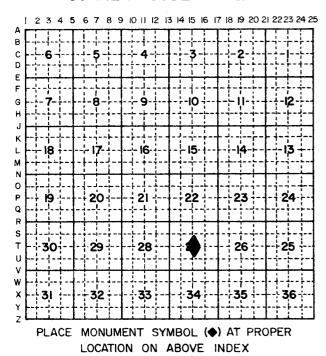


IF AVAILABLE STATE PLANE COORDINATES

For Miscellaneous Corners within Sec. 27 ,T. 4 N., R. 14 E.

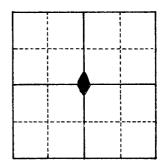

- Above code numbers are positioned Meander, Claim, or Fractional corners of the section.
- Township corner code numbers shall be applied to the corners of above typical section.

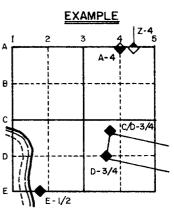

North (Y)285,653.60 Eleve. (Z) 919 East (X) 2,314,751.64 Zone South Hor. Datum _____ Vert. Datum CORNER MONUMENT

O WITNESS MONUMENT FOUND CAST IRON MON CENTER OF SECTION 27 LIMA FIELD BOOK Page 50

SHOW A PLAN VIEW DRAWING DEPICTING THE CORNER MONUMENT AND SURROUNDING PHYSICAL FEATURES, INCLUDING THE EXCAVATION AREA AND DEPTH. THE CORNER MONUMENT SHALL HAVE THE FOLLOWING CHARACTERISTICS: I) HAVE AT LEAST TWO PREDETERMINED BREAK-OFF POINTS. 2) IF BROKEN, LEAVE A PERMANENTLY MAGNETIZED REMNANT AT THE ORIGINAL POINT. 3) MUST BE EXTENDABLE. 4) THE CAP IS INSCRIBED : ROCK COUNTY SURVEY MONUMENT - PENALTY FOR DISTURBING MARKER. 5) OR AN EXISTING CUT LIMESTONE. AN IRON PIPE 1 2" x 4'0" (MINIMUM) WITH AT LEAST 4 DURABLE WITNESS MONUMENTS MAY BE USED IN AREAS WHERE GROUND WATER IS WITHIN 1.0' OF THE SURFACE. IF THE CORNER IS OCCUPIED BY AN IMPROVEMENT (MANHOLE, BURIED CABLE, ETC.), ANY DURABLE, DISTINCT MONUMENT MAY BE USED AND REFERENCED WITH AT LEAST 4 DURABLE WITNESS MONUMENTS.

CORNER CODE: T-15

FOUND CAST IRON MONUMENT	
Describe any material discorner as restored or re-corner as previously restored	crepancy between the location of the established and the location of that ored or re-established.
Was the corner restored the evidence location or a for	hrough acceptance of an obliterated und perpetuated location.
ACCEPTED FOUND PERPETUATED I	LOCATION
·	
methods? If so, show the distances to other public	shed through lost corner proportionate method, including directions and land survey corners used as evidence in determination of the corner locatio
as identified by the corne , establishe recovered or restored as e regulations and rules as r	hereby certify that the corner pointer code index were, in a field survey or ed, re-established, monumented, re-monumented below and in conformance with required in the current manual of survey states Department of Interior, Bureau
	COUNTY SURVEYOR FILING DATA
	Date of Computer Entry
A SECTION A. VAN	Date Received
ECTALO A. S.	

AFFIX YOUR LAND SURVEYOR SEAL. T/5