U.S. PUBLIC LAND SURVEY MONUMENT RECORD


For Public Land Survey Corners in the

LIMA

T. 4 N., R.14 E.

CORNER CODE INDEX

For Miscellaneous Corners within Sec. 22 T. 4 N., R. 14 E.

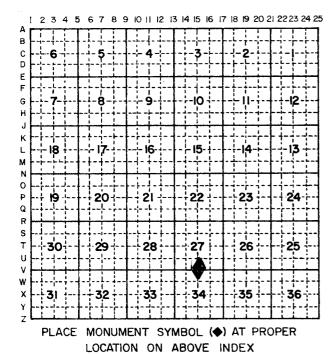

Above code numbers are positioned Meander, Claim, or Fractional 1. corners of the section.

Township corner code numbers shall be applied to the corners of above typical section.


> **EXAMPLE** D-3/4

IF AVAILABLE STATE PLANE COORDINATES

North (Y) 283 020 16 Eleve. (Z) 924

East (X) 2314 952 52 Zone South

Hor. Datum _____ Vert. Datum

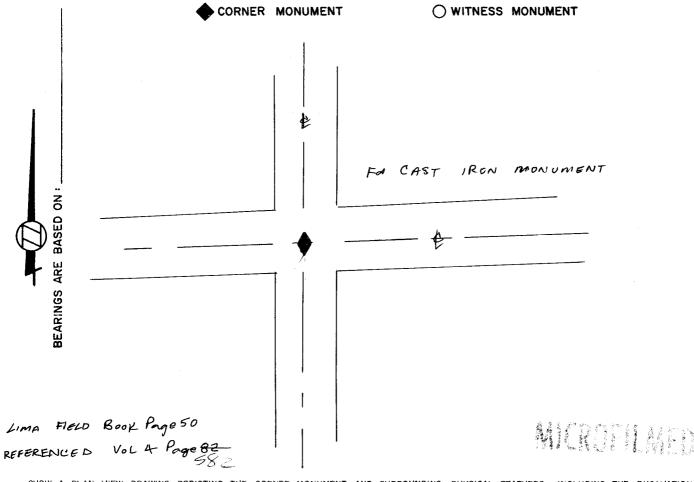

SHOW A PLAN VIEW DRAWING DEPICTING THE CORNER MONUMENT AND SURROUNDING PHYSICAL FEATURES, INCLUDING THE EXCAVATION AREA AND DEPTH. THE CORNER MONUMENT SHALL HAVE THE FOLLOWING CHARACTERISTICS: I) HAVE AT LEAST TWO PREDETERMINED BREAK-OFF POINTS. 2) IF BROKEN, LEAVE A PERMANENTLY MAGNETIZED REMNANT AT THE ORIGINAL POINT. 3) MUST BE EXTENDABLE. 4) THE CAP IS INSCRIBED : ROCK COUNTY SURVEY MONUMENT - PENALTY FOR DISTURBING MARKER, 5) OR AN EXISTING CUT LIMESTONE. AN IRON PIPE 1/2" x 4'0" (MINIMUM) WITH AT LEAST 4 DURABLE WITNESS MONUMENTS MAY BE USED IN AREAS WHERE GROUND WATER IS WITHIN 1.0' OF THE SURFACE. IF THE CORNER IS OCCUPIED BY AN IMPROVEMENT (MANHOLE, BURIED CABLE, ETC.), ANY DURABLE, DISTINCT MONUMENT MAY BE USED AND REFERENCED WITH AT LEAST 4 DURABLE WITNESS MONUMENTS.

CORNER CODE:

FO	UND MONUMENT OF RECORD
Dar	
COI	scribe any material discrepancy between the location of the cner as restored or re-established and the location of that
cor	oner as previously restored or re-established.
Was evi	s the corner restored through acceptance of an obliterated dence location.
	CCEPTED FOUND PERPETUATED LOCATION
	CCEPTED FOUND PERPETUATED LOCATION
Vas	the corner re-established through lost corner proportionate
met	the corner re-established through lost corner proportionate hods? If so, show the method, including directions and
met dis	hods? If so, show the method, including directions and tances to other public land survey corners used as evidence
met dis	hods? If so, show the method, including directions and tances to other public land survey corners used as evidence used for proportioning in determination of the corner location
net dis or	hods? If so, show the method, including directions and tances to other public land survey corners used as evidence used for proportioning in determination of the corner location
net dis or	hods? If so, show the method, including directions and tances to other public land survey corners used as evidence used for proportioning in determination of the corner location
net dis or	hods? If so, show the method, including directions and tances to other public land survey corners used as evidence used for proportioning in determination of the corner locatio
netdis Or No.	hods? If so, show the method, including directions and tances to other public land survey corners used as evidence used for proportioning in determination of the corner location.
metdisor No.	hods? If so, show the method, including directions and tances to other public land survey corners used as evidence used for proportioning in determination of the corner location of th
and tances to other public land survey corners used as evidence used for proportioning in determination of the corner location of the corner location of the corner location of the corner point identified by the corner code index were, in a field survey of the corner code index we
Nor No	hods? If so, show the method, including directions and tances to other public land survey corners used as evidence used for proportioning in determination of the corner location of the corner location of the corner location of the corner point identified by the corner code index were, in a field survey of the corner code index we
Nor No	nods? If so, show the method, including directions and tances to other public land survey corners used as evidence used for proportioning in determination of the corner location on the corner location on the corner point identified by the corner code index were, in a field survey of 1982, established, re-established, monumented, re-monumented or restored as expressed below and in conformance with sulations and rules as required in the current manual of survet tructions of the United States Department of Interior, Bureau Land Management. COUNTY SURVEYOR FILING DATA Date of Computer Entry
Nor No	hods? If so, show the method, including directions and tances to other public land survey corners used as evidence used for proportioning in determination of the corner locatic october to the corner locatic october to the corner locatic october to the corner point identified by the corner code index were, in a field survey of the corner code index were, in a field survey october to the corner code index were, in a field survey october to the corner code index were, in a field survey of the corner code index were, in a fie
No.	Another public land survey corners used as evidence used for proportioning in determination of the corner location of the corner code index were, in a field survey of the corner code index were, in a field survey of the corner location of the corner code index were, in a field survey of the corner code index were, in a fi
Nor No	hods? If so, show the method, including directions and tances to other public land survey corners used as evidence used for proportioning in determination of the corner location on the location of the corner location on the location of location of the location of loc