## U.S.


## LAND PUBLIC SURVEY MONUMENT RECORD

For Public Land Survey Corners in:

WI ADMINISTRATIVE CODE A-E 7.08 REQUIREMENT

T. 2 N., R. 14 E

CORNER CODE INDEX

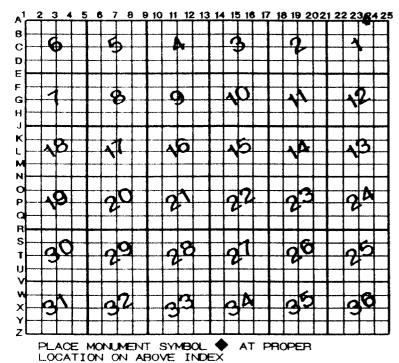

KOSH	KONONI	<u>5</u> T	WP
	COUNTY		

IF AVAILABLE ROCK COUNTY COORDINATES PERFERRED

North	Elev
East	-
Hor. Datum	Vert. Datum
LATITUDE .	ELLIPS. H
LONGITUTE	
GPS (X)	TRAVERSE (X)
BASED ON THE	FOLLOWING CONTROL:

**♦**CORNER MONUMENT

WITNESS MONUMENT

(a)

THOMAS WOLLIN, JEFFERSON COUNTY SURVEYOR, PROVIDED THE STATE PLANE COORDINATES FOR CORNER CODE #5/0/ CORS/A SEC 36 T 5 N R/4 E

STATE PLANE COORDINATES N/S 309,582,758
NAD 1983/91 OF RECORD E/W 2,293, 828,044/

I DONALD BARNES CONVERTED THE ABOVE COORDINATES TO THE FOLLOWING:

LATITUDE 42,50-34,47527 LONGITUDE 88-47-12,98420 MERIDIAN CONV. 0-50- 046 SCALE FACTOR 0, 9999797106

ROCK COUNTY COORDINATES (NAD 1983/91) N/S 327, 575, 555

E/W 556, 5/6,087

SCALE 1, 000 0026 883

CONVERGENCE: THE ANGULAR DIFFERENCE BETWEEN THE GEODETIC NORTH & THE ROCK

COUNTY MERCATOR NORTH

DEGO MIN // SEC 38.4

Darold Barres 2/12/03

ш
ᇤ
₹
S
SS
ž
Ξ
ų,
۹
ш
$\mathbf{m}$

Ż

FIELD	воок	PAGE #_				SHEET	OF	
SHOW	A PLAN VIEW	DRAWING DE	PICTING TH	E CORNER	MONUMENT	AND SURRO	UNDING	
PHYSIC	AL FEATURES,	INCLUDING 1	HE EXCAVA	ATION AREA	A AND DEPTH	H.	1 4.4	TOD
PLANNING	3 & ZONING COM	MITTEE ADOPTI	ED THE ABOV	E FORM ON	12/2/1982	File	in LIMA	$/\omega_{f}$
				(	A AND DEPTH 12/2/1982 CORNER	CODE	A-23/	24

GOVERNMENT LAND CO	RNER RECORD	<b>)</b> *		r101
JEFFERSON COUNT	TY	. <del>_</del>	CORNER NO	5101
TYPE OF MONUMENT Aluminum Mag	netized		ı	
STATE PLANE COORDINATES N. 30	9582.758		T. 4 - 5	5 <b>N</b> .
NAD 1983/91 <u>E. 22</u> 9	$3828.041  5\frac{1}{4}-36$			• •
ELEVATION M.S.L. DATUM:				
Grid-Ground 1.0000545381	135		36 3	36 \ Gov't
FIELD BOOK Koshkonong p.	±//	2	1 1	Jog = 4.62'
DRAWN BY		ع د		Pro-rated
		4	R. 14	E.
BASIS FOR MONUMENTATION			wis.	<b>_</b> _ <b>L</b> •
Criginal Survey, 1834-37, Wood Po.	st & Bearing Trees		ILL. BASE	LINE
Resurvey of Koshkonong Township,	y Milo C. Jones.			
August-December, 1886. Field note Tree evidence was found. From the	es say that Bearing	SEAL:		<b>-</b>
stone monument, Approx. 6" by 36"	long with a squared	31	Massac COV	S CORPORATE OF THE PROPERTY OF
finished top, was set for the cor	er. Notes recorded		WISCON	2/1/8
in the Register of Deeds, Miscellanders 389-412.	neous Volume 1,		THOMAS	) <u>e</u>
1974, Dug in corner area with a Ba	ckhoe but did not	-	WOLLIN	1 1 " E
find the stone monument. I re-est	ablished the corner		THOMAS WOLLIN S-1355 JEFFERSO WI	
on the Townline and in line with			WI	/O.S
An iron pipe was set for the corner 1980, I removed the iron pipe and		1	80 V	Esse
Magnetized Monument for the corner	• AT ATUITIUM		VI, SUR	1163901
3/1985, I furthur checked for the		-	-444444	••
digging with a backhoe in the area cables on the Northside of the Roa		DATA SH	OWN HERE ON	
the stone monument. I re-set the		CERTIFIE	D CORRECT:	
where it had been. A telephone ca		Royn	as R. Wi	-Chine
of it, about 3' below ground surfa			RED LAND SURVE	
3/18/2002, G.P.S. coordinates are GP-SX1 single-frequency receiver w	assigned. A Topcon	DATED _	6/25/1	982
LOCATION SKETCH	as week		×	
EUCATION SKETCH			₹	N
SQUARE CUT LIMESTONE			P	1
CONCRETE / BRASS CAP	†a]o	phone	Ŷ	Field
<del></del>		estal	36 <b>½</b> 36	11010
ALUMINUM MAGNETIZED 2" by 54" O IRON PIPE	-		<b>X</b>	į.
O RR SPIKE	Underground	AHHHAMA		1
+ PK NAIL	telephone cables	1,,,,		11117
FENCE			{	
UTILITY POLE		3	ა ა ი	
TL STEEL POST/SIGN		1!	- 8	•
MAINTENANCE RECORD		} ;	್ರ ಶಾಂದ Count	y line Road
DATE INIT. REMARKS	<b></b>	1 1	Sount Count	-)
3/1985 TRW further diagrams.	***			
1 000	-			
	<b>-</b>			
		i 1	<b>)</b>	
	-		Field	
		ł		

\* II C PHREIC LAND CHRVEY MONHMENT BECORD