U.S.


PUBLIC LAND SURVEY MONUMENT RECORD

For Public Land Survey Corners in:

WI ADMINISTRATIVE CODE A-E 7.08 REQUIREMENT

T.4N, R. 14E

CORNER CODE INDEX

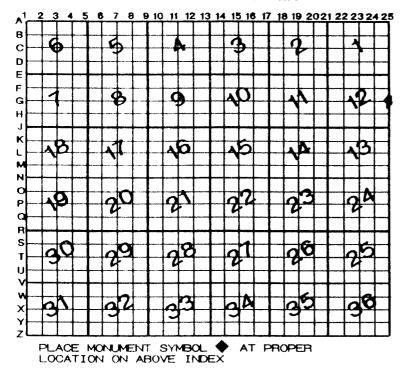

41	TWP	
ROCK	COUNTY	WI

IF AVAILABLE ROCK COUNTY COORDINATES PERFERRED

North	***************************************	Elev.	

East ____

Hor. Datum _____ Vert. Datum ____

____ ELLIPS. HT.

LONGITUTE

GPS (X) ___ TRAVERSE (X) ___

BASED ON THE FOLLOWING CONTROL:

CORNER MONUMENT

O WITNESS MONUMENT

LATITUDE

(a)

SHEET # 45

CONCRETE MON /BRASS Cap N=301,293.0Z K-296.56663

E = 296, 966, 63 INFORMATION IS FROM WIDOT DISTRICT 2 R/W PLAT - PROJECT 1080-00-22, DATED 11-26-1997 & LAST REVISION DATE OF 8-7-2001.

"THIS PLAT HAS GROUND COORDINATES THAT ARE ADJUSTED TO GPS POINTS WHITEWATER AND ELKHORN USING GPS TECHNOLOGY.

"COORDINATES ON THIS PLAN ARE REFERENCED TO THE WISCONSIN STATE PLANE COORDINATE SYSTEM (WSPCS), 'SOUTH' ZONE" NAD83(91)

"TO CONVERT GROUND COORDINATE (N & E) TO GRID COORDINATES (X & Y) MULTIPLY GROUND (N & E) BY FACTOR 0.9999441 AND ADD 2,000,000 TO THE X COORDINATE." ELEVATIONS ARE BASED ON NGVD29

NOTE: THE COORDINATES ARE <u>NOT</u> BASED ON THE ROCK COUNTY PROJECTION. BY USING THE GIS I DETERMINED THEY ARE PROBABLY NOT WALWORTH, DANE, OR JEFFERSON COUNTY PROJECTIONS, BUT I COULD NOT FIND ANY CALL ON THE MAPS.

Parabbanes 6-25-03

FIELD	BC	OOK		PAGE	#		_			•	SHEET	
SHOW	Α	PLAN	VIEW	DRAWING	DEPI	CTING	THE	CORNER	MONUMENT	AND	SURRO	UNDING
PHYSIC	AL	FEAT	URES,	INCLUDI	IG THE	EXC	AVAT	ION AREA	AND DEPT	H.		
PLANNIN	G 8	ZONIN	G COM	MITTEE AL	OPTED	THE A	BOVE	FORM ON	12/2/1982			

CORNER CODE G-25(1)

BEARINGS ARE BASED ON: