

U.S. PUBLIC LAND SURVEY MONUMENT RECORD

For Public Land Survey Corners In:

WI ADMINISTRATIVE CODE A-E 7.08 REQUIREMENT

T. 4N. R. 14E. 4th P.M.

REV 10/23/2004

USMONREC.DWG

CORNER CODE INDEX

A	1	2	3	4	5	6	7	8	9	10	11	12	13	14	15	16	17	18	19	20	21	22	23	24	25	A
B			6				5				4				3			2				1				B
C																										C
D																										D
E																										E
F																										F
G																										G
H																										H
J																										J
K																										K
L																										L
M																										M
N																										N
O																										O
P																										P
Q																										Q
R																										R
S																										S
T																										T
U																										U
V																										V
W																										W
X																										X
Y																										Y
Z																										Z

LIMA TWP

ROCK COUNTY WI

IF AVAILABLE
ROCK COUNTY COORDINATES PREFERRED

North _____ Elev. _____

East _____

Hor. Datum _____ Vert. Datum _____

LATITUDE _____ ELLIPS. HT. _____

LONGITUDE _____

NAD83(91) _____ NETWORK ADJ. YR _____

GPS (X) _____ TRAVERSE (X) _____

BASED ON THE FOLLOWING CONTROL:

PLACE MONUMENT SYMBOL AT PROPER LOCATION ON ABOVE INDEX

CORNER MONUMENT

WITNESS MONUMENT

(a)

BEARINGS ARE BASED ON: _____

FIELD BOOK _____ PAGE # _____

SHEET 1 OF 1

SHOW A PLAN VIEW DRAWING DEPICTING THE CORNER MONUMENT AND SURROUNDING PHYSICAL FEATURES, INCLUDING THE EXCAVATION AREA AND DEPTH.

PLANNING & ZONING COMMITTEE ADOPTED THIS FORM ON 12/2/1982

CORNER CODE J-25 (3)

RECORD OF U. S. PUBLIC LAND SURVEY CONTROL STATION

U. S. PUBLIC LAND SURVEY CORNER 12|7 T 4 N, R 14|15 E, ROCK/WALWORTH COUNTY, WISCONSIN
13|18

HORIZONTAL CONTROL SURVEY BY: AYRES ASSOCIATES YEAR: 2004
 VERTICAL CONTROL SURVEY BY: AYRES ASSOCIATES YEAR: 2004

STATE PLANE COORDINATES OF: SECTION CORNER
 NORTH 298,624.31
 EAST 2,328,078.03
 ELEVATION OF STATION: 885.672

HORIZONTAL DATUM: WISCONSIN STATE PLANE COORDINATE SYSTEM, SOUTH ZONE
 NORTH AMERICAN DATUM OF 1927

VERTICAL DATUM: NATIONAL GEODETIC VERTICAL DATUM OF 1929


THETA ANGLE: +0-50-24

CONTROL ACCURACY:

HORIZONTAL: THIRD ORDER, CLASS I

VERTICAL: SECOND ORDER, CLASS II


LOCATION SKETCH:

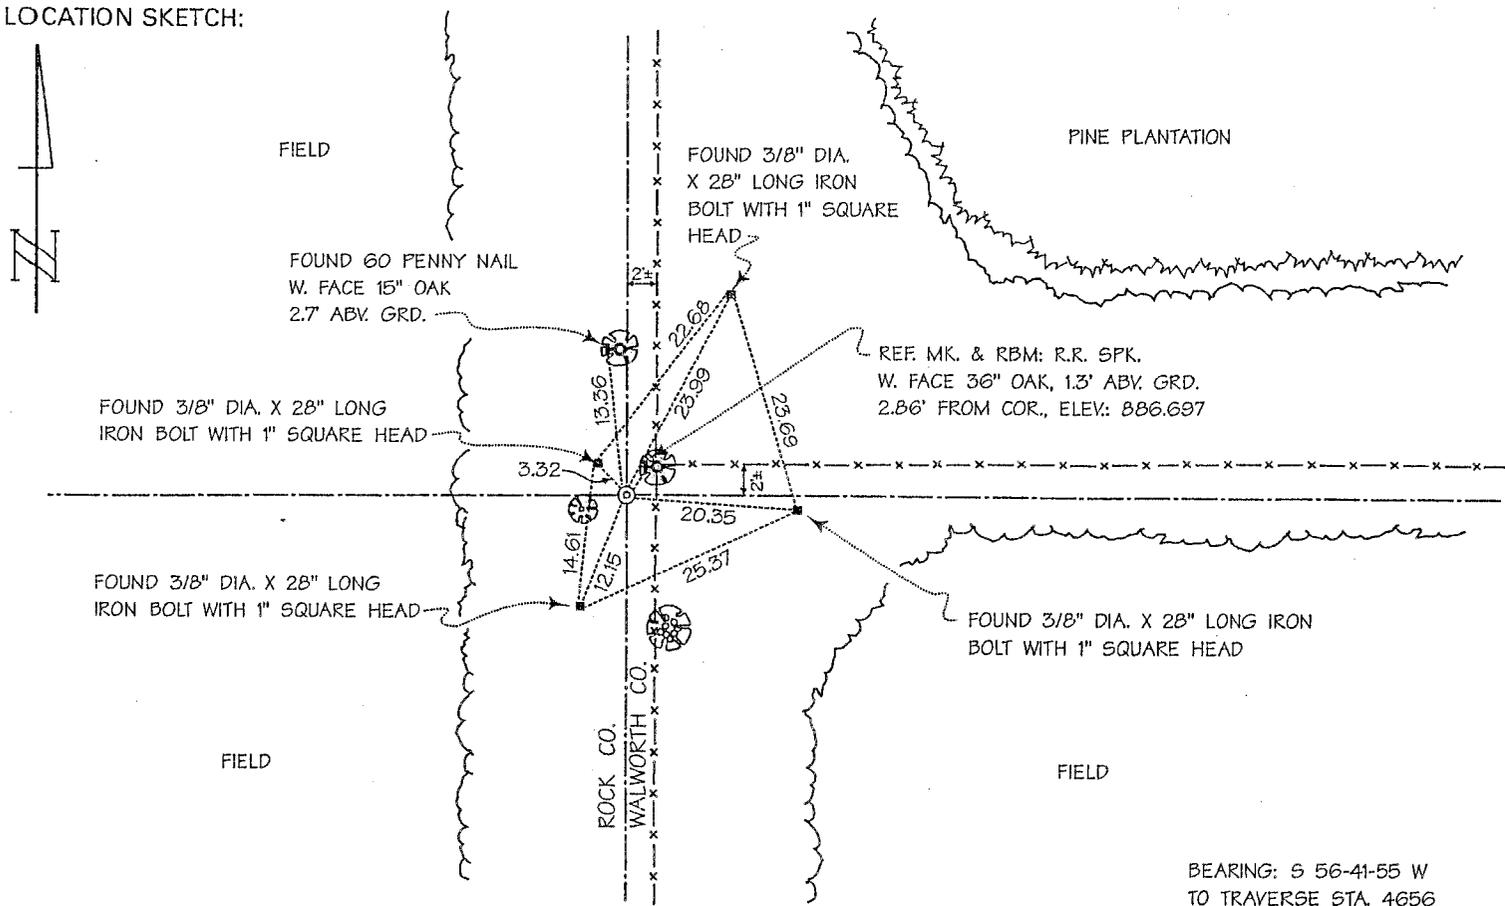

SURVEYOR'S AFFIDAVIT:

STATE OF WISCONSIN) SS
WALWORTH COUNTY)

As Walworth County Surveyor, I hereby certify that I found a galvanized steel pipe with Walworth County brass cap as set to mark this corner in May 1996 by Lloyd L. Jensen, S-211, Walworth County Surveyor; replacing a plastic monument with Rock County aluminum cap set to mark this corner in May 1983 by Donald A. Barnes, S-1216, Rock County Surveyor; using single proportionate measurement between the west one-quarter corner of Section 12 and the west one-quarter corner of Section 13, Township 4 North, Range 14 East; that excavation by Mr. Barnes did not reveal the existence of any monumentation marking this corner; that I referenced the same as shown hereon; and that this record is correct and complete to the best of my knowledge and belief.

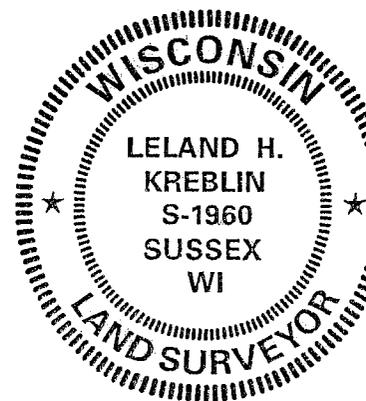

DATE OF SURVEY: 18 NOVEMBER 2004
 REVISED: 25 MAY 2005

Leland H. Kreblin
 REGISTERED LAND SURVEYOR

S - 1960