
## PUBLIC LAND U.S. SURVEY MONUMENT RECORD

For Public Land Survey Corners In: WI ADMINISTRATIVE CODE A-E 7.08 REQUIREMENT REV 10/23/2004 USMONREC.DWG T.4N. R. /5 E. 4th P.M. CORNER CODE INDEX LIMA **TWP** 

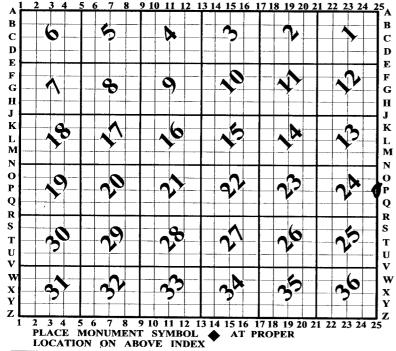

**ROCK COUNTY WI** 

IF AVAILABLE ROCK COUNTY COORDINATES PERFERRED

Elev.

ELLIPS. HT.

East

Hor. Datum \_\_\_\_\_ Vert. Datum

LONGITUDE

NAD83(91) \_\_\_\_\_NETWORK ADJ. YR

GPS (X) \_\_\_\_ TRAVERSE (X) \_\_\_\_ BASED ON THE FOLLOWING CONTROL:

**◆ CORNER MONUMENT** 

**WITNESS MONUMENT** 

LATITUDE

North

BEARINGS ARE BASED ON:\_

(a)

FIELD BOOK PAGE # SHEET SHOW A PLAN VIEW DRAWING DEPICTING THE CORNER MONUMENT AND SURROUNDING PHYSICAL FEATURES, INCLUDING THE EXCAVATION AREA AND DEPTH. PLANNING & ZONING COMMITTEE ADOPTED THIS FORM ON 12/2/1982

BECORD (	) FII	C	PUBLIC LA	NID	SHRVEY	CONTROL	STATION
NECOND (	JE U.	Ο.	FUDLIC LA	AIND.	JU1111 L	COMINGE	OIMIOIN

24 | 19 24 | 19 ROCK/WALWORTH N, R 14/15 E, \_ COUNTY, WISCONSIN U. S. PUBLIC LAND SURVEY CORNER AYRES ASSOCIATES YEAR: 2004 HORIZONTAL CONTROL SURVEY BY: YEAR: 2004 AYRES ASSOCIATES VERTICAL CONTROL SURVEY BY: STATE PLANE COORDINATES OF: QUARTER SECTION CORNER 290,696.47 NORTH 2,328,018.88 **EAST ELEVATION OF STATION:** 869.268 HORIZONTAL DATUM: WISCONSIN STATE PLANE COORDINATE SYSTEM, SOUTH ZONE NORTH AMERICAN DATUM OF 1927 VERTICAL DATUM: NATIONAL GEODETIC VERTICAL DATUM OF 1929 THETA ANGLE: +0-50-22 CONTROL ACCURACY: VERTICAL: SECOND ORDER, CLASS II THIRD ORDER, CLASS I HORIZONTAL: LOCATION SKETCH: 8 PASTURE FIELD WOODED FOUND CONC. WIT. MON. WITH BRASS CAP FOUND CONC. WIT. MON. WITH BRASS CAP FOUND CONC. WIT. MON. FOUND CONC. WIT. MON. WITH BRASS CAP WITH BRASS CAP RD. **ISLAND** 63.63 3 <del>(})</del> REF. MK. & RBM: SET R.R. SPK. W. FACE 28" BOX ELDER FIELD 0.8' ABV. GRD., ELEV.: 869.946 BEARING: S 89-24-31 E TO TRAVERSE STA. 5377 FIELD

SURVEYOR'S AFFIDAVIT:

STATE OF WISCONSIN) WALWORTH COUNTY)

SS

As Walworth County Surveyor, I hereby certify that I found a concrete monument with Walworth County brass cap as set to mark this corner in October 1997 by Lloyd L. Jensen, S-211, Walworth County Surveyor; replacing a broken cast iron monument, said cast iron monument having been set to mark this corner in May 1983 by Donald A. Barnes, S-1216, Rock County Surveyor, using single proportionate measurement between the northeast and southeast corners of Section 24, Township 4 North, Range 14 East; that I referenced the same as shown hereon; and that this record is correct and complete to the best of my knowledge and belief.

DATE OF SURVEY:

14 JUNE 2004

REGISTERED LAND SURVEYOR

1960

92

LELAND H.

KREBLIN

S-1960

SUSSEX

WI

SUSSEX

SUSSEX

WI

SUSSEX

WI

SUSSEX

SUSSEX

SUSSEX

WI

SUSSEX

SUSSEX

WI

SUSSEX

SUSSEX

SUSSEX

SUSSEX

WI

SUSSEX

P-25(1)