
PUBLIC LAND U.S. SUR MONUMENT RECORD

For Public Land Survey Corners in:

WI ADMINISTRATIVE CODE A-E 7.08 REQUIREMENT

T. 2 N., R. 14 E

CORNER CODE INDEX

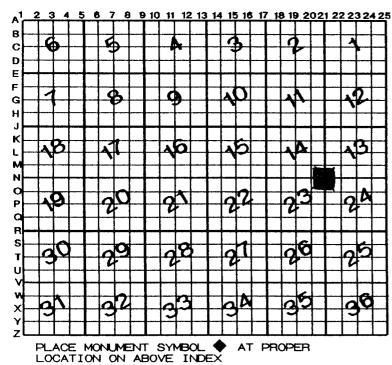

Z/MIA	T	W	F
	•		

ROCK COUNTY WI

IF AVAILABLE

F	ROCK	COUNT	Y COORDINATES	PEF	REPRED	_
North	***************************************		EI	ev.		
East			-			
Hor. I	Datu	m	Vert. D	atu	m	
LATIT	UDE	-	***************************************		ELLIPS. H	1
LONG	TUTI	E .				-
GPS	(X)	***************************************	TRAVER	SE	(x)	
BASED	ON	THE	FOLLOWING	co	NTROL:	

WITNESS MONUMENT **♦**CORNER MONUMENT (a) 3/4 REBAR WITH CAP STEEL FENCE POST BASED ON: \$ 574 59 45 4 6 BEARINGS ARE BERNTSEN

FIELD	воок	 P.A	\GE	#	_27
		 		•••	

SHEET .

SHOW A PLAN VIEW DRAWING DEPICTING THE CORNER MONUMENT AND SURROUNDING PHYSICAL FEATURES, INCLUDING THE EXCAVATION AREA AND DEPTH.

PLANNING & ZONING COMMITTEE ADOPTED THE ABOVE FORM ON 12/2/1982

3/4 REBAR 25' OFF E STH 59

FOUND

(B) Describe any record evidence, monument evidence, occupational evidence, testimonial evidence or any other material evidence you considered, and whether the monument was found or placed.

BERNISEN MONUMENT FOUND IN CORNIFICIO PRIVICUS FIE SHELT OF NO LISE.

C) Was the corner restored through acceptance of (1) an oblicerated evidence location, or, (2) a found perpotushed localion?

D) Describe any material discrepancy between the location of the corner as restored or reestablished and the location of that corner as previously restored or reestablished by distance and direction. Show the discrepancy on the plan view drawing under (a), above. Show the distances between the corner as previously restored or reestablished and (1) the corner as restored or reestablished, and (2) to at least 4 of the witness monuments shown on the drawing in (a), above.

LOCATION OF CORNER FITS WITH RECERDED DISTANCES TO NY 23 AND 61/4 14.

(E) Was the corner reestablished through lost corner proportionate methods? If so, show the method, including the directions and distances to other public land survey corners used as evidence or used for proportioning the corner location.

I, Timiethy J. Mark hereby certify that the corner location as identified by the corner code index was determined by me under by direction and control and that this U.S. Public Land Survey Monument Record is correct and complete to the best of my knowledge and belief.

To MADIC WILLIAM TO THE PROPERTY OF THE PROPERTY TIME THE JAMES seal $\mathcal{P}_{\text{Number of included sheets}}^{\text{Number of included sheets}}$ emboss / stamped CORNER CODE

A-E 7.08 REQUIREMENT

N21()